

SURVEY &  
REMONUMENTATION

1993

COMMISSION

CHEBOYGAN COUNTY REMONUMENTATION CORNER  
LAND CORNER RECORDATION CERTIFICATE  
Filing Requirement of Act 74, Mich. P.A. 1970

For corners in

Cheboygan Located In: Corner Code #  
(County)

1. Public Land Survey T 36NR 1E A-8  
T \_\_\_\_\_ R \_\_\_\_\_  
T \_\_\_\_\_ R \_\_\_\_\_  
T \_\_\_\_\_ R \_\_\_\_\_

2. Property Controlling S \_\_\_\_\_ T \_\_\_\_\_ R \_\_\_\_\_  
in Section S \_\_\_\_\_ T \_\_\_\_\_ R \_\_\_\_\_

3. Miscellaneous S \_\_\_\_\_ T \_\_\_\_\_ R \_\_\_\_\_  
Property in Sec. S \_\_\_\_\_ T \_\_\_\_\_ R \_\_\_\_\_

4. Lot No. \_\_\_\_\_, Recorded Plat \_\_\_\_\_

5. Private Claims \_\_\_\_\_

RECEIVED  
FOR RECORD

93 NOV 24 PM 4: 33

*James H. Granger*  
CLERK/REGISTER  
CHEBOYGAN COUNTY, MICHIGAN

Register of Deeds Stamp & File Number

I, James H. Granger, in a field survey on November 1 - 12, 19 93, do hereby certify that under requirements of P.A. 74, Michigan P.A. of 1970, the corner points mentioned in lines 1 and 2 above were in conformance with regulations and rules therefore as required in the current manual of survey instructions of the United States Department of the Interior, Bureau of Land Management or by a decree of a Court of Law and/or that the corner points mentioned in lines 3, 4 and 5 above were in conformance with the rules of the Michigan Board of Land Surveyors or by a Decree of a Court of Law; established, re-established, monumented, re-monumented, recovered, found as expressed below:

NOTE: Not more than 4 corners, all in the same town and range, may be recorded on this certificate.

A. Description of original monument and accessories and/or subsequent restoration:  
1840 Original Survey John Hodgson  
Set Wood Post  
10" Aspen S 48° E 12 lks  
7" Balsam S 85° W 23 lks  
1983 Orlando Doyle #7319


B. Description of corner evidence found and/or method applied in restoring or reestablishing corner:

Fd 1" pipe  
Found three 1983 witnesses

*Marvin O. Ross*

Position accepted as most probable location of original monument set.


	A	B	C	D	E	F	G	H	I	J	K	L	M
2	6		5		4		3		2		1		
3													
4	7		8		9		10		11		12		
5													
6	13		17		16		15		14		13		
7													
8	19		20		21		22		23		24		
9													
10	30		29		28		27		26		25		
11													
12	31		32		33		34		35		36		
13													

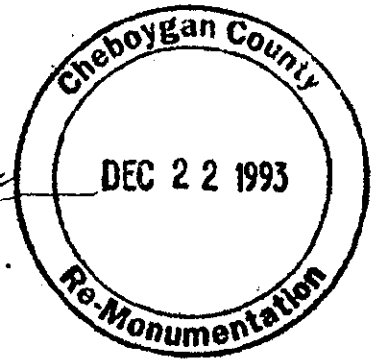

LIBER 010 PAGE 07

C. Description of monument for corner and accessories established to perpetuate locating the position of the corner:

5/8" x 30" rod with 3" dia. alumin. cap  
8" Maple S 69° W 8.54' fd nail & washer  
10" Maple N 35° E 13.99' fd nail & washer  
4" Birch S 60° E 7.37' fd nail & washer  
Set nail & tag PS #16041 in:  
6" Birch S 21° W 16.17'

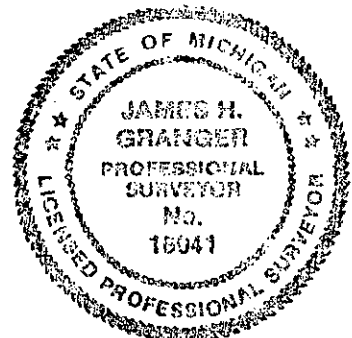

Signed by James H. Granger  
Surveyor's Michigan License No. 16041

Date Nov. 24, 1993