

*James H. Granger*  
1993  
COMMISSION

CHEBOYGAN COUNTY REMONUMENTATION CORNER  
LAND CORNER RECORDATION CERTIFICATE  
Filing Requirement of Act 74, Mich. P.A. 1970

For corners in  
Cheboygan

(County)	Located In:	Corner Code #
1. Public Land Survey	T <u>36N</u> R <u>1E</u>	<u>A-9</u>
	T _____ R _____	_____
	T _____ R _____	_____
	T _____ R _____	_____
2. Property Controlling in Section	S _____ T _____ R _____	_____
	S _____ T _____ R _____	_____
3. Miscellaneous Property in Sec.	S _____ T _____ R _____	_____
	S _____ T _____ R _____	_____
4. Lot No. _____, Recorded Plat _____		
5. Private Claims _____		

RECEIVED FOR RECORD  
93 NOV 24 PM 4: 37  
*James H. Granger*  
CLERK/REGISTER  
CHEBOYGAN COUNTY, MICHIGAN

Register of Deeds Stamp & File Number

I, James H. Granger, in a field survey on November 1 - 12, 19 93, do hereby certify that under requirements of P.A. 74, Michigan P.A. of 1970, the corner points mentioned in lines 1 and 2 above were in conformance with regulations and rules therefore as required in the current manual of survey instructions of the United States Department of the Interior, Bureau of Land Management or by a decree of a Court of Law and/or that the corner points mentioned in lines 3, 4 and 5 above were in conformance with the rules of the Michigan Board of Land Surveyors or by a Decree of a Court of Law; established, re-established, monumented, re-monumented, recovered, found as expressed below:

**NOTE: Not more than 4 corners, all in the same town and range, may be recorded on this certificate.**

	A	B	C	D	E	F	G	H	I	J	K	L	M
2	6	5	4	3	2	1							
3													
4	7	8	9	10	11	12							
5													
6	18	17	16	15	14	13							
7													
8	19	20	21	22	23	24							
9													
10	30	29	28	27	26	25							
11													
12	31	32	33	34	35	36							
13													

A. Description of original monument and accessories and/or subsequent restoration:


1840 Original Survey John Hodgson  
Corner is 26" Hemlock  
No witnesses set  
1982 Ron Bischer #22428  
1983 Orlando Doyle #7319  
1988 James H. Granger #16041

B. Description of corner evidence found and/or method applied in restoring or reestablishing corner:

Fd 1" axle  
Found two 1988 witnesses with tags  
Found two witnesses with tag #15410

Position accepted as most probable location of original monument set.


*Morris O. Ray*

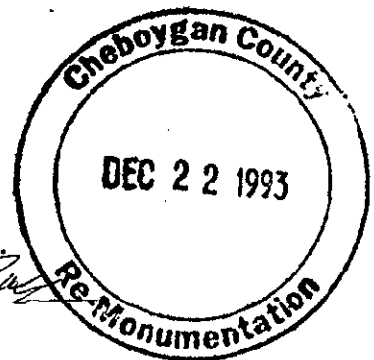

LIBER 010 PAGE 08

C. Description of monument for corner and accessories established to perpetuate locating the position of the corner:

5/8" x 30" rod with 3" dia. alumin. cap  
Power pole S 39° E 47.39' fd spike & tag #15410  
Anchor pole S 49° W 47.38' fd spike & tag #15410  
Anchor pole N 60° E 41.89' fd nail & tag LS #16041  
12" Scotch Pine North 54.01' fd nail & tag LS #16041

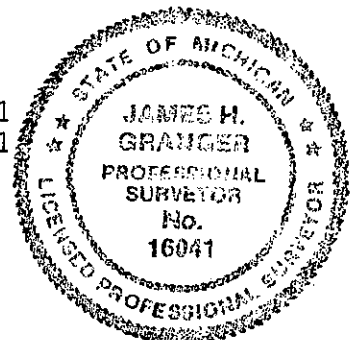

Signed by *James H. Granger*  
Surveyor's Michigan License No. 16041

Date Nov. 24, 1993