

**SURVEY & REMONUMENTATION**

*James H. Granger*  
 1993  
**COMMISSION**

**CHEBOYGAN COUNTY REMONUMENTATION CORNER  
 LAND CORNER RECORDATION CERTIFICATE  
 Filing Requirement of Act 74, Mich. P.A. 1970**

For corners in  
Cheboygan  
(County)

Located In: Corner Code -#

1. Public Land Survey	T	36N	R	1E	A-11
	T		R		
	T		R		
	T		R		
2. Property Controlling in Section	S		T	R	
	S		T	R	
3. Miscellaneous Property in Sec.	S		T	R	
	S		T	R	

RECEIVED FOR RECORD  
 93 NOV 24 PM 4:43

*James H. Granger*  
 CLERK/REGISTER  
 CHEBOYGAN COUNTY, MICHIGAN

Register of Deeds Stamp & File Number

4. Lot No. \_\_\_\_\_, Recorded Plat \_\_\_\_\_  
 5. Private Claims \_\_\_\_\_

	A	B	C	D	E	F	G	H	I	J	K	L	M
2	6	5	4	3	2	1							
3													
4	7	8	9	10	11	12							
5													
6	18	17	16	15	14	13							
7													
8	19	20	21	22	23	24							
9													
10	30	29	28	27	26	25							
11													
12	31	32	33	34	35	36							
13													

I, James H. Granger, in a field survey on November 1 - 12, 1993, do hereby certify that under requirements of P.A. 74, Michigan P.A. of 1970, the corner points mentioned in lines 1 and 2 above were in conformance with regulations and rules therefore as required in the current manual of survey instructions of the United States Department of the Interior, Bureau of Land Management or by a decree of a Court of Law and/or that the corner points mentioned in lines 3, 4 and 5 above were in conformance with the rules of the Michigan Board of Land Surveyors or by a Decree of a Court of Law; established, re-established, monumented, re-monumented, recovered, found as expressed below:

**NOTE: Not more than 4 corners, all in the same town and range, may be recorded on this certificate.**

A. Description of original monument and accessories and/or subsequent restoration:


- 1840 Original Survey John Hodgson  
 Set Wood Post  
 7" Cedar N 83° E 11 lks  
 10" Black Ash S 17° W 9 lks
- 1982 Ron Bischer #22428
- 1983 Orlando Doyle #7319
- 1988 James H. Granger #16041

B. Description of corner evidence found and/or method applied in restoring or reestablishing corner:

Fd 1 1/2" pipe  
 Found four 1988 witnesses

Position accepted as most probable location of original monument set.


*Morris A. P...*

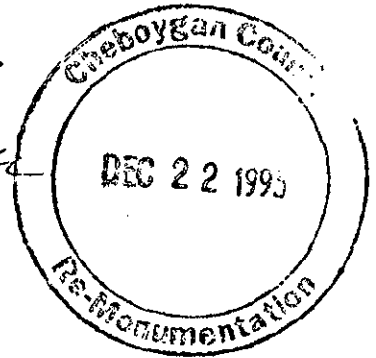

LIBER **010** PAGE **10**

C. Description of monument for corner and accessories established to perpetuate locating the position of the corner:

- 5/8" x 30" rod with 3" dia. alumin. cap
- 8" Cedar S 12° W 13.58' fd nail & tag LS #16041
- 5" Cedar N 57° W 9.44' fd nail & tag LS #16041
- 8" Poplar N 33° E 6.08' fd nail & tag LS #16041
- 8" Cedar S 87° E 12.08' fd nail & tag LS #16041

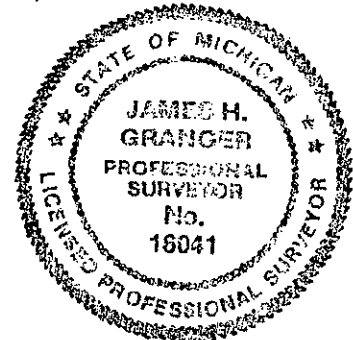

Signed by James H. Granger  
 Surveyor's Michigan License No. 16041

Date Nov. 24, 1993