

SURVEY & REMONUMENTATION

CHEBOYGAN COUNTY REMONUMENTATION CORNER

MAY 3 1995

LAND CORNER RECORDATION CERTIFICATE

DEC 29 1994

COMMISSION

Filing Requirement of Act 74, Mich. P.A. 1970

RECORDED FOR RECORD
of 12:41 O'Clock P.M.

For corners in Cheboygan (County)

Located In: Corner Code #

- 1. Public Land Survey T 36N R 1W A-8
- 2. Property Controlling in Section S T R
- 3. Miscellaneous Property in Sec. S T R
- 4. Lot No. , Recorded Plat
- 5. Private Claims

Jas. Spray

CLERK/REGISTER
CHEBOYGAN COUNTY, MICHIGAN

Register of Deeds Stamp & File Number

	A	B	C	D	E	F	G	H	I	J	K	L	M
2	6	5	4	3	2								
3													
4	7	8	9	10	11	12							
5													
6	18	17	16	15	14	13							
7													
8	19	20	21	22	23	24							
9													
10	30	29	28	27	26	25							
11													
12	31	32	33	34	35	36							
13													

I, Richard C. Dunn, in a field survey on October, 19 94, do hereby certify that under requirements of P.A. 74, Michigan P.A. of 1970, the corner points mentioned in lines 1 and 2 above were in conformance with regulations and rules therefore as required in the current manual of survey instructions of the United States Department of the Interior, Bureau of Land Management or by a decree of a Court of Law and/or that the corner points mentioned in lines 3, 4 and 5 above were in conformance with the rules of the Michigan Board of Land Surveyors or by a Decree of a Court of Law; established, re-established, monumented, re-monumented, recovered, found as expressed below:

NOTE: Not more than 4 corners, all in the same town and range, may be recorded on this certificate.

A. Description of original monument and accessories and/or subsequent restoration:

G.L.O. John Mullett 1840
Set Wood Post
10" Cedar at 1/4 Post


Dean Delameter #5778, March 1961
Liber B, page 8
Fnd. 1" Iron Pipe
12" Cedar N51°E 14.60'
6" Cedar S16°W 8.75'
5" Cedar N80°W 15.81'

Delmer Porter, #15410, Oct. 17, 1974
Liber 1, page 149
Fnd. 1" Pipe by 3" Sq. Cedar Stake
8" Maple N70°W 21.07'
4" Maple N25°W 28.15'
4" Cedar S80°E 17.91'

B. Description of corner evidence found and/or method applied in restoring or reestablishing corner:

Fnd. 1" Pipe by 3" sq. Cedar Post per Delmer Porter survey dated October 17, 1974 as recorded in Liber 1, Page 149.


Morris P...

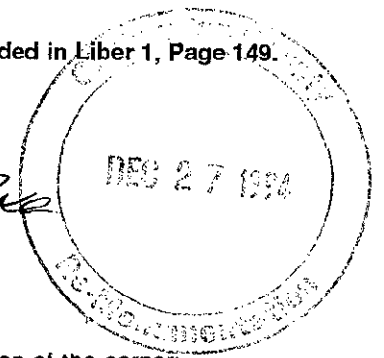

C. Description of monument for corner and accessories established to perpetuate locating the position of the corner:

A-8 Fnd. 1" Pipe by 3" S. Cedar Post and replaced with 5/8" x 30" Iron Bar and 3" aluminium cap and is accepted as a careful and faithful reestablishment of the position of the original corner.
7" Maple N25°E 26.06'
6" Cedar S80°E 17.55'
12" Maple N70°W 21.04'
4" Cedar S35°E 7.58'
(Line cut to South & East & West)

LIBER 010 PAGE 89

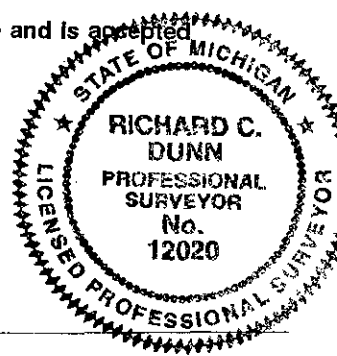

Signed by *Richard C. Dunn*

Date December 15, 1994

Surveyor's Michigan License No. 12020