

SURVEY & REMONUMENTATION

CHEBOYGAN COUNTY REMONUMENTATION CORNER

MAY 03 1995

LAND CORNER RECORDATION CERTIFICATE
Filing Requirement of Act 74, Mich. P.A. 1970

DEC 29 1994

For corners in Cheboygan **COMMISSION**
(County)

Located In: Corner Code #

RECEIVED FOR RECORD
at 12:42 O'Clock P M

James Spray

CLERK/REGISTER
CHEBOYGAN COUNTY, MICHIGAN

Register of Deeds Stamp & File Number

| | | | | | |
|------------------------------------|---|-----|---|----|-----|
| 1. Public Land Survey | T | 36N | R | 1W | A-9 |
| | T | | R | | |
| | T | | R | | |
| | T | | R | | |
| 2. Property Controlling in Section | S | | T | R | |
| | S | | T | R | |
| 3. Miscellaneous Property in Sec. | S | | T | R | |
| | S | | T | R | |

4. Lot No. _____, Recorded Plat _____
5. Private Claims _____

| | A | B | C | D | E | F | G | H | I | J | K | L | M |
|----|----|---|----|---|----|---|----|---|----|---|----|---|---|
| 2 | 6 | | 5 | | 4 | | 3 | | 2 | | 1 | | |
| 3 | | | | | | | | | | | | | |
| 4 | 7 | | 8 | | 9 | | 10 | | 11 | | 12 | | |
| 5 | | | | | | | | | | | | | |
| 6 | 18 | | 17 | | 16 | | 15 | | 14 | | 13 | | |
| 7 | | | | | | | | | | | | | |
| 8 | 19 | | 20 | | 21 | | 22 | | 23 | | 24 | | |
| 9 | | | | | | | | | | | | | |
| 10 | 30 | | 29 | | 28 | | 27 | | 26 | | 25 | | |
| 11 | | | | | | | | | | | | | |
| 12 | 31 | | 32 | | 33 | | 34 | | 35 | | 36 | | |
| 13 | | | | | | | | | | | | | |

I, Richard C. Dunn, in a field survey on October, 19 94, do hereby certify that under requirements of P.A. 74, Michigan P.A. of 1970, the corner points mentioned in lines 1 and 2 above were in conformance with regulations and rules therefore as required in the current manual of survey instructions of the United States Department of the Interior, Bureau of Land Management or by a decree of a Court of Law and/or that the corner points mentioned in lines 3, 4 and 5 above were in conformance with the rules of the Michigan Board of Land Surveyors or by a Decree of a Court of Law; established, re-established, monumented, re-monumented, recovered, found as expressed below:

NOTE: Not more than 4 corners, all in the same town and range, may be recorded on this certificate.

A. Description of original monument and accessories and/or subsequent restoration:


G.L.O. John Mullett 1840
Set Wood Post
14" Beech N66°E 36 Links
10" Hemlock S39°E 36 Links

Delmer Porter #15410, Oct. 1974
Liber 355, page 526
Fnd. 5/8" rod in Mon. Box
8" Maple S15°E 91.11'
Large Rock S45°E 65.0'

B. Description of corner evidence found and/or method applied in restoring or reestablishing corner:

Fnd. 5/8" iron bar in Mon. Box as per Delmer Porter survey, recorded in Liber 355, Page 526.


Marvin A. Ross

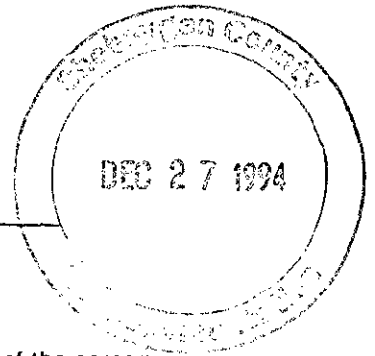

C. Description of monument for corner and accessories established to perpetuate locating the position of the corner:

A-9 Placed 3" aluminum cap on 5/8" iron bar in monument box per Liber 355, Page 526, Cheboygan County Records, Cheboygan County, Michigan, and is accepted as a careful and faithful reestablishment of the original corner.
3' x 3' x 3' rock with chiseled X on top S27°E 64.62'
Fence post N22°W 41.38'
1/2" bar N61°E 37.00'
1/2" bar S60°W 40.53° 200' plus or minus East of Road intersection

LIBER 010 PAGE 90

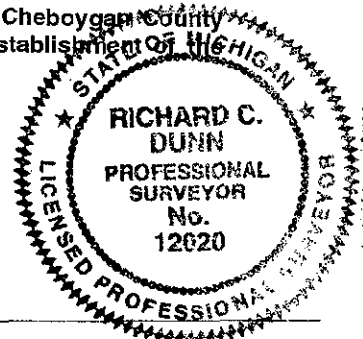

igned by Richard C. Dunn

Date December 15, 1994

urveyor's Michigan License No. 12020