


MICHIGAN
DEPARTMENT OF CONSERVATION
FORESTRY DIVISION

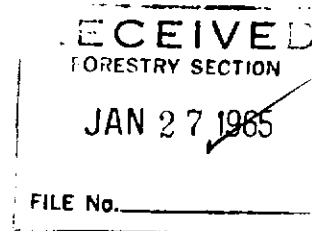

LAND CORNER RECORD

T. 36 N.R. 1 W.


Cheboygan COUNTY

DESCRIPTION OF CORNER 1/4 corner common to Sections 34 - 35

CORNER MONUMENT 1" pipe with 4" aluminum cap

DATE MONUMENT PLACED AND WITNESSED November 13, 1964

WITNESSES TO CORNER..... _____

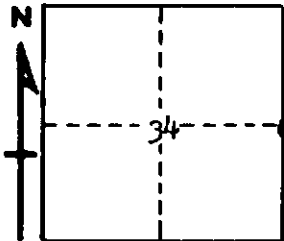

CIRCLE CORNER REGISTERED

7" Cedar S 51 W 23.3'

5" Cedar N 9 W 12.2'

AND _____

DESCRIPTION IN DETAIL AS TO HOW CORNER WAS LOCATED AND IDENTIFIED OR RESTORED.

This corner was found while making a survey in this area. Found squared post at corner and a very old stake point. NW BT stump in place with very good face.

SURVEYOR'S SEAL

SIGNED *Kenneth J. Ostling* DATE January 20, 1965
REGISTERED LAND SURVEYOR #10068