


MICHIGAN
DEPARTMENT OF CONSERVATION
FORESTRY DIVISION

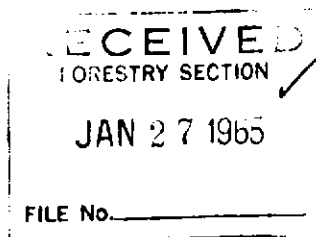

LAND CORNER RECORD

T. 36 N. R. 1 W.


Cheboygan COUNTY

DESCRIPTION OF CORNER 1/4 corner common to Sections 30 - 31

CORNER MONUMENT Set 1" pipe with 4" aluminum cap

DATE MONUMENT PLACED AND WITNESSED November 19, 1964

WITNESSES TO CORNER.....

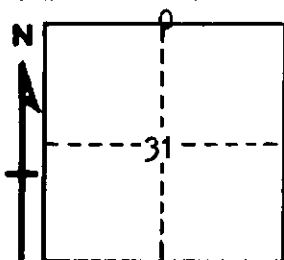

CIRCLE CORNER REGISTERED

7" J. Pine S 21 E 25.1'

4" R. Pine N 51 E 18.2'

AND

DESCRIPTION IN DETAIL AS TO HOW CORNER WAS LOCATED AND IDENTIFIED OR RESTORED.

This corner was set by proportionate measurement while making a survey in this area. No positive evidence of original corner.

SURVEYOR'S SEAL

SIGNED

Kenneth J. Stilling
REGISTERED LAND SURVEYOR #10068

DATE November 19, 1964