

MICHIGAN
DEPARTMENT OF CONSERVATION
FORESTRY DIVISION

LAND CORNER RECORD


T. 35 N. R. 1W
T. 36 W. 1W
CHEBOYGAN COUNTY

DESCRIPTION OF CORNER ± CORNER COMMON TO SECTIONS 3 - 34

CORNER MONUMENT 1" PIPE WITH 4" ALUMINUM CAP

DATE MONUMENT PLACED AND WITNESSED JUNE 22, 1965

WITNESSES TO CORNER.....

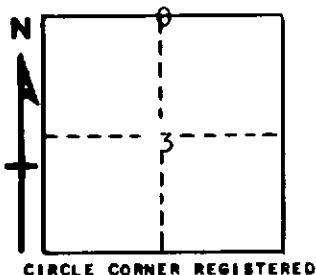

16" WHITE BIRCH S66W 47.9

7" BASSWOOD N66W 39.3

AND

DESCRIPTION IN DETAIL AS TO HOW CORNER WAS LOCATED AND IDENTIFIED OR RESTORED.

THIS CORNER WAS SET BY PROPORTIONATE MEASUREMENT MIDPOINT ON LINE, BETWEEN SECTION CORNERS. NO ORIGINAL EVIDENCE.

SURVEYOR'S SEAL

SIGNED Kenneth Ostling DATE JUNE 22, 1965
REGISTERED LAND SURVEYOR
K. J. Ostling, #10068