

MICHIGAN
DEPARTMENT OF CONSERVATION
FORESTRY DIVISION



LAND CORNER RECORD

T. 36 N.R. 1W


CHEBOYGAN COUNTY

DESCRIPTION OF CORNER SECTION CORNER COMMON TO SECTIONS 25 - 26 - 35 - 36

CORNER MONUMENT SET 1" PIPE WITH 4" ALUMINUM CAP

DATE MONUMENT PLACED AND WITNESSED _____

WITNESSES TO CORNER..... _____

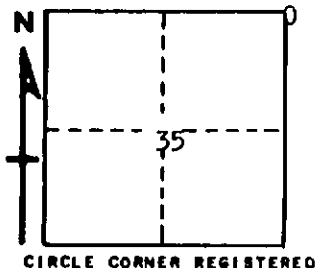

8" CEDAR S5E 30.0

7" CEDAR N37E 9.8

AND

7" CEDAR N36W 12.4

DESCRIPTION IN DETAIL AS TO HOW CORNER WAS LOCATED AND IDENTIFIED OR RESTORED.

THIS CORNER WAS FOUND WHILE MAKING A SURVEY IN THIS AREA. FOUND 1½" PIPE AND OLD POST AT CORNER, WHICH WAS PREVIOUSLY RESTORED FROM U.S.B.T.'S. NW W. PINE LONG-BUTT DOWN, BUT INTACT, WITH BOTH FACES IDENTIFIED. OTHER NBTS ALSO. CHECK GOOD TO SWAMP EDGES. VERY GOOD ORIGINAL CORNER.

SURVEYOR'S SEAL

SIGNED *Kenneth J. Ostling* DATE JUNE 30, 1965
REGISTERED LAND SURVEYOR
K. J. Ostling #10068