

# LAND CORNER RECORDATION CERTIFICATE

Filing Requirement of Act 74, Mich. PA 1970

For Corners In:  
Cheboygan Located In \_\_\_\_\_ Corner Code # \_\_\_\_\_  
 (County)

- |                                      |             |              |             |          |
|--------------------------------------|-------------|--------------|-------------|----------|
| 1. Public Land Survey                | T _____     | R _____      |             |          |
|                                      | T _____     | R _____      |             |          |
| 2. Property Controlling in Section   | S <u>16</u> | T <u>36N</u> | R <u>2W</u> | <u>3</u> |
|                                      | S <u>16</u> | T <u>36N</u> | R <u>2W</u> | <u>4</u> |
| 3. Miscellaneous Property in Section | S _____     | T _____      | R _____     |          |
|                                      | S _____     | T _____      | R _____     |          |


4. Lot No: \_\_\_\_\_ Recorded Plat: \_\_\_\_\_

5. Private Claims: \_\_\_\_\_

I, Carl T. Kiiskila, in a field survey on February 6, 2002 do hereby state that under requirements of PA 74, Michigan PA of 1970, the corner points mentioned in lines 1 and 2 above were in conformance with regulations and rules therefore as required in the current manual of survey instructions of the United States Department of the Interior, Bureau of Land Management or by a decree of a Court of Law and/or that the corner points mentioned in lines 3, 4 and 5 above were in conformance with the rules of the Michigan Board of Land Surveyors or by a Decree of a Court of Law; established, re-established, monumented, recovered, found as expressed below:

**NOTE: Not more than 2 corners, all in the same town and range, may be recorded on this certificate.**

Register of Deeds Stamp & File Number

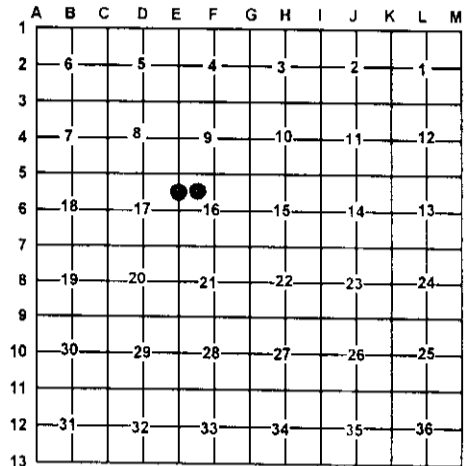

A. Description of original monument and accessories and/or subsequent restoration:

3- This corner position was not established during the original government survey.

4- This corner position was not established during the original government survey.

B. Description of corner evidence found and/or method applies in restoring or re-establishing corner:

3- Established the Northwest corner of the Southwest quarter of the Northwest quarter of section 16 as per B.L.M. instruction for the subdivision of a section.

4- Established the Northeast corner of the Southwest quarter of the Northwest quarter of section 16 as per B.L.M. instructions for the subdivision of a section.

C. Description of monument for corner and accessories established to perpetuate locating the position of the corner:

- 3- Set 5/8" X 32" rerod with P.S. cap #33981  
 Wit: 14" Oak N25°W 10.44'  
 3" White Birch N61°E 23.14'  
 4" Maple S29°E 7.09'  
 8" White Birch S07°W 32.41'  
 Carsonite Post North 1±

- 4- Set 5/8" X 32" rerod with P.S. cap #33981  
 Wit: 4" Maple N16°E 8.79'  
 6" Maple S65°W 17.86'  
 3" Maple S07°W 15.24'  
 12" Basswood S65°E 27.61'  
 Found 1" pipe N82°W 14.50'  
 Found 1/2" bar  
 W/P.S. cap #38121 N66°W 3.62'  
 Carsonite Post North 1±

Signed by: \_\_\_\_\_

*Carl T. Kiiskila*

Date: \_\_\_\_\_

4-8-03

Surveyor's Michigan License No.: 33981

