

1999

1998 CHEBOYGAN COUNTY REMONUMENTATION LAND CORNER RECORDATION CERTIFICATE Filing Requirement of Act 74, Mich. P.A. 1970

For corners in SECTION

Cheboygan (County)

Table with columns: Located In, Corner Code #. Includes codes like T36N R 3W, A-1, M-1, A-13, M-13.

1. Public Land Survey

2. Property Controlling in Section

3. Miscellaneous Property in Sec.

4. Lot No. , Recorded Plat
5. Private Claims

I, Brian K. Fullford, in a field survey on June, 1998 do hereby state that under requirements of P.A. 74, Michigan P.A. of 1970, the corner points mentioned in lines 1 and 2 above were in conformance with regulations and rules therefore as required in the current manual of survey instructions of the United States Department of the Interior, Bureau of Land Management or by a decree of a Court of Law and/or that the corner points mentioned in lines 3, 4 and 5 above were in conformance with the rules of the Michigan Board of Land Surveyors or by a Decree of a Court of Law; established, re-established, monumented, recovered, found as expressed below:

NOTE: Not more than 2 corners, all in the same town and range, may be recorded on this certificate.

NOTE: THIS CORNER IS ALSO DESIGNATED AS CODE M-1, T36N-R4W, CODE A-13, T37N-R3W, & CODE M-13, T37N-R4W.


A. Description of original monument and accessories and/or subsequent restoration:

G.L.O. 1893 Sidney Main, County Surveyor
1840 Wm. Burt
Set Post Fnd stumps of Gov't bearing trees;
12" Hemlock N 13° E 17 lks Set N.B.T.'s
12" Hemlock S 57 1/2° W 25 lks 8" Birch N 5° 45' E 28 3/4 lks
6" Birch S 6° E 80 lks
4' Cedar post S 0° E, 50 lks
4' Cedar post N 0° E 50 lks

Sept 1976
Herbert Fluharty #18223
Fnd spike in Black-Top
6' +/- East of Fence to North
off Fence to South
Road sign N 30° W 22.33'
6" Poplar S 27° W 50.56'
10" Tw. Maple S 14° E 60.40'

B. Description of corner evidence found and/or method applied in restoring or reestablishing corner:

Fnd 5/8" re-rod in monument box 1' North of centerline road
Fnd Fence to South
Fnd 8" Poplar S 27° W 50.61 w/nail & blaze
Fnd 14" Tw. Maple S 14° E 60.21 w/nail & blaze
Fnd 10" Cedar N 33° W 37.22 w/tag 15401
Fnd road sign N 30° W 22.85

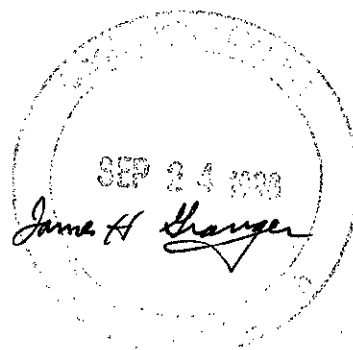

C. Description of monument for corner and accessories established to perpetuate locating the position of the corner:

A-1 Placed remonumentation cap on 5/8" rebar in monument box, and position is accepted as a careful and faithful perpetuation of the original corner.

1' North of road centerline
Fence to South
8" Poplar S 27° W 50.61' w/nail & blaze
14" Tw. Maple S 14° E 60.21' w/nail & blaze
10" Cedar N 33° W 37.22' w/tag 15401
Road sign N 30° W 22.85'



Signed by [Signature]
Surveyor's Michigan License No. 41099

Date 11/23/98