

RECEIVED
FOR RECORD

1999 CHEBOYGAN COUNTY REMONUMENTATION
LAND CORNER RECORDATION CERTIFICATE
Filing Requirement of Act 74, Mich. P.A. 1970

JAN -3 PM 12:48

Vicky Pyszynski

For corners in
Cheboygan

Located In: Corner Code #

CLERK/REGISTER
CHEBOYGAN COUNTY MICHIGAN

MAR 03 2000

SECTION

Register of Deeds Stamp & File Number

1. Public Land Survey	T36N R3W	A-3
	T36N R4W	M-3
	T R	
	T R	
2. Property Controlling in Section	S T R	
	S T R	
3. Miscellaneous Property in Sec.	S T R	
	S T R	

4. Lot No. _____, Recorded Plat _____
5. Private Claims _____

I, Brian K. Fullford, in a field survey on Sept., 1999 do hereby state that under requirements of P.A. 74, Michigan P.A. of 1970, the corner points mentioned in lines 1 and 2 above were in conformance with regulations and rules therefore as required in the current manual of survey instructions of the United States Department of the Interior, Bureau of Land Management or by a decree of a Court of Law and/or that the corner points mentioned in lines 3, 4 and 5 above were in conformance with the rules of the Michigan Board of Land Surveyors or by a Decree of a Court of Law; established, re-established, monumented, recovered, found as expressed below:

NOTE: Not more than 2 corners, all in the same town and range, may be recorded on this certificate.

This corner is also designated as M-3 in T36N-R4W.


A	B	C	D	E	F	G	H	I	J	K	L	M
1												
2	6	5	4	3	2	1						
3												
4	7	8	9	10	11	12						
5												
6	18	17	16	15	14	13						
7												
8	19	20	21	22	23	24						
9												
10	30	29	28	27	26	25						
11												
12	31	32	33	34	35	36						
13												

A. Description of original monument and accessories and/or subsequent restoration:

Original Survey 1840 W. Burt Set Post 9" Hemlock S70°W 8 Lks. 10" Maple N45°E 5 Lks	Resurvey 1855 Fnd Post 7" Hemlock S48°E 6 Lks. 16" Hemlock N25°E 26 Lks.	Oct. 1892 S.G. Main (County Surveyor) Fnd post w/old Gov't bearings Set new fine post w/new bearings 12" W. Pine N45°W 66 Lks. 7" Cedar N31°30'E 90 1/2 Lks.	Sept. 1976 H. Fluharty Rls. #18223 Set 5/8 X 18" re-rod w/rts cap on N. side of fence post, Fnd 10"X18" stone on S. side of fence post, conceded 2 way, fence to W 9" Maple S39°E 18.26' 6" Maple N22°E 33.89' 7" Maple Cluster S13°W 32.68'
---	---	---	---

B. Description of corner evidence found and/or method applied in restoring or reestablishing corner:

Fnd Conc Mon w/U of M cap RLS #7319 on North-South fence line
12" Maple S39°E 18.26' No tag
Maple stump N22°E 33.89 No tag

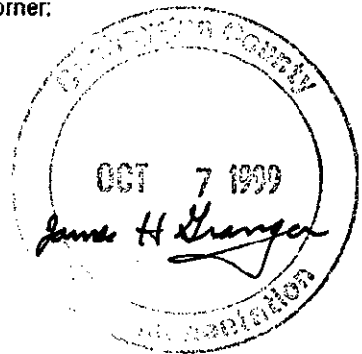

C. Description of monument for corner and accessories established to perpetuate locating the position of the corner:

- A-3 Use existing concrete monument with U of M cap RLS #7319. Position is accepted as a careful and faithful perpetuation of the original corner.
 - Fence line to North & South
 - 4" Spruce N71°E 4.53' w/nail
 - 4" Spruce S25°E 15.80' w/nail
 - 5" Poplar S71°W 33.86' w/nail
 - 11" Maple N55°W 39.75' w/nail
 - 12" Maple S39°E 18.26



Signed by *B. K. Fullford*
Surveyor's Michigan License No. 41099

Date 12/17/99