

RECEIVED FOR RECORD

00 JAN -3 PM 12:47

1999 CHEBOYGAN COUNTY REMONUMENTATION

LAND CORNER RECORDATION CERTIFICATE
Filing Requirement of Act 74, Mich. P.A. 1970

Dicki Pyzymski
CLERK/REGISTER
CHEBOYGAN COUNTY MICHIGAN

For corners in

Cheboygan

(County)

Located In:

Corner Code #

1. Public Land Survey

T36N R 3W A-5

T36N R 4W M-5

T R

T R

2. Property Controlling in Section

S T R

S T R

3. Miscellaneous Property in Sec.

S T R

S T R

BY

MAR 03 2000

SECTION
Register of Deeds Stamp & File Number

4. Lot No. _____, Recorded Plat _____
5. Private Claims _____

I, Brian K. Fullford, in a field survey on Sept., 1999 do hereby state that under requirements of P.A. 74, Michigan P.A. of 1970, the corner points mentioned in lines 1 and 2 above were in conformance with regulations and rules therefore as required in the current manual of survey instructions of the United States Department of the Interior, Bureau of Land Management or by a decree of a Court of Law and/or that the corner points mentioned in lines 3, 4 and 5 above were in conformance with the rules of the Michigan Board of Land Surveyors or by a Decree of a Court of Law; established, re-established, monumented, recovered, found as expressed below:

NOTE: Not more than 2 corners, all in the same town and range, may be recorded on this certificate.

This corner is also designated as M-5 in T36N-R4W.

	A	B	C	D	E	F	G	H	I	J	K	L	M
1													
2	6		5		4		3		2		1		
3													
4	7		8		9		10		11		12		
5													
6	18		17		16		15		14		13		
7													
8	19		20		21		22		23		24		
9													
10	30		29		28		27		26		25		
11													
12	31		32		33		34		35		36		
13													

A. Description of original monument and accessories and/or subsequent restoration:

1840 J. Mullett
Original Survey
Set Post
10" Birch N4½°W 20 Lks.
6" Birch S45°W 5 Lks.


Resurvey 1855
Found Post
20" W. Pine N45°E 36 Lks.
10" Elm S10°E 29 Lks.

Feb 1980
J. Green
Rls. #15401
Fnd 1 ¼" Pipe
7" Maple S42°W 67.92'
3" Maple N34°W 42.25'
4" Hemlock S24°E 47.95'

June 1980
J. Green
Rls. #15401
Fnd 1 ¼" Pipe (per Doyle wits)
7" Maple S42°W 67.92'
3" Maple N34°W 42.25'
4" Hemlock S24°E 47.96'

B. Description of corner evidence found and/or method applied in restoring or reestablishing corner:

Fnd 1 ¼" pipe bent w/nail @base 1' North of road centerline
7" Maple S40°W 67.9' no tag
4" Balsam S42°E 47.9' no tag w/old scar

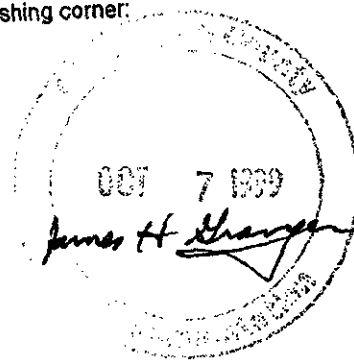

C. Description of monument for corner and accessories established to perpetuate locating the position of the corner:

A-5 Replaced bent 1 ¼" pipe with 5/8" X 36" bar and remonumentation cap and monument box. Position is accepted as careful and faithful perpetuation of the original corner.

12" Maple S40°W 67.90'
4" Maple clump N36°W 49.74'
6" Balsam S42°W 47.73'
10" Spruce N3°W 43.85'
5/8" bar w/cap 16051 North 33.00'

Set tag 41099
Set tag 41099
Set tag 41099
Set tag 41099



Signed by

B. K. Fullford

Surveyor's Michigan License No.

41099

Date

12/17/99