

RECEIVED FOR RECORD

00 JAN -3 PM 12:50

1999 CHEBOYGAN COUNTY REMONUMENTATION
LAND CORNER RECORDATION CERTIFICATE
Filing Requirement of Act 74, Mich. P.A. 1970

Cheryl Pyzyrski
CLERK/REGISTER
CHEBOYGAN COUNTY MICHIGAN

For corners in
Cheboygan
(County)

Located In: Corner Code #

1. Public Land Survey

T36N	R3W	A-9
T36N	R4W	M-9
T	R	
T	R	
S	T	R
S	T	R
S	T	R
S	T	R

2. Property Controlling in Section

3. Miscellaneous Property in Sec.

4. Lot No. _____, Recorded Plat _____
5. Private Claims _____

Register of Deeds Stamp & File Number

MAR 03 2000

I, Brian K. Fullford, in a field survey on Sept., 1999 do hereby state that under requirements of P.A. 74, Michigan P.A. of 1970, the corner points mentioned in lines 1 and 2 above were in conformance with regulations and rules therefore as required in the current manual of survey instructions of the United States Department of the Interior, Bureau of Land Management or by a decree of a Court of Law and /or that the corner points mentioned in lines 3, 4 and 5 above were in conformance with the rules of the Michigan Board of Land Surveyors or by a Decree of a Court of Law; established, re-established, monumented, recovered, found as expressed below:

NOTE: Not more than 2 corners, all in the same town and range, may be recorded on this certificate.

This corner is also designated as M-9 in T36N-R4W.


A	B	C	D	E	F	G	H	I	J	K	L
1											
2	6		5		4		3		2		1
3											
4	7		8		9		10		11		12
5											
6	19		17		16		15		14		13
7											
8	19		20		21		22		23		24
9											
10	30		29		28		27		26		25
11											
12	31		32		33		34		35		36
13											

A. Description of original monument and accessories and/or subsequent restoration:

1840 Orig. Survey J. Mullett Set Post 9" Cedar N73°W 20 Lks. 12" Cedar S84°W 24 Lks.	Fnd old post Set musket barrel w/cedar post 8" Cedar N59°30' W 65 Lks. 18" Cedar S21°E 52 Lks.	Jan 1962 D. Delamater Rls. 5778 Found 1/2" iron pipe 10" Cedar N17°W 52.7' P. Pole S69°E 76.2'	P. Pole Az. 227° 39.79' 10" Cedar Az. 341° 52.53'
1855 Resurvey Set Corner 16" W. Pine N5°W 25 Lks. 16" Cedar S87°W 25 Lks.	Mar. 1958 T. Schweigert Rls. 6525 Found 1/2" pipe Set T iron over pipe	Nov. 1972 . Verba Rls. 13603 Found Conc. Mon.	Jan. 1973 D. Verba Rls. 13603 Found Conc. Mon. P. Pole Az. 73° 97.20 Face Conc. r.o.w. Mon. Az. 130° 42.13'
1893 S. Main Emmet Co. Surveyor	P. Pole S69°E 76.2' 10" Cedar N17°W 52.7'	P. Pole Az. 73° 97.20' Face Conc. r.o.w. Mon. Az. 130° 42.13'	P. Pole Az. 227° 39.79' 10" Cedar Az. 341° 52.53'

B. Description of corner evidence found and/or method applied in restoring or reestablishing corner:

Fnd Mon Box 3" below asphalt w/no lid
Inside Mon box fnd conc mon along with 1/2" iron pipe and 1/2" iron bar bent
P.Pole N73°E 97.20' with tag 13603
Face of conc r-o-w mon S50°E 42.13'
P.Pole S47°W 39.79' w/tag 10698

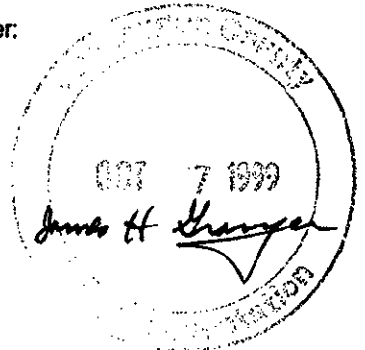

C. Description of monument for corner and accessories established to perpetuate locating the position of the corner:

- A-9 Use existing concrete monument set remonumentation cap ^N and monument box. Position is accepted as a careful and faithful perpetuation of the original corner.
 - P. Pole N73°E 97.20' w/tag 13603
 - Face of Conc. r-o-w mon. S50°E 42.13'
 - P. Pole S47°W 39.79' w/tag 10698
 - P. Pole N68°W 88.63' Set tag 41099

Signed by B. K. Fullford
Surveyor's Michigan License No. 41099

Date 12/17/99

