

March 1999
 COUNTY OF
 REMONUMENTATION

APR 23 1999

1998

CHEBOYGAN COUNTY REMONUMENTATION
 LAND CORNER RECORDATION CERTIFICATE
 Filing Requirement of Act 74, Mich. P.A. 1970

SECTION

For corners in
Cheboygan
 (County)

Located In:	Corner Code #
T 36NR 3W	C-1 ✓
T 37N R 3W	C-13
T R	
T R	
S T R	
S T R	
S T R	
S T R	

RECEIVED FOR RECORD 1-8-99
 at 8:58 O'Clock A M
Jeanne Spray
 CLERK/REGISTER
 CHEBOYGAN COUNTY, MICHIGAN
 Register of Deeds Stamp & File Number

- Public Land Survey
- Property Controlling in Section
- Miscellaneous Property in Sec.
- Lot No. _____, Recorded Plat _____
- Private Claims _____

I, Brian K. Fullford, in a field survey on June, 1998, do hereby state that under requirements of P.A. 74, Michigan P.A. of 1970, the corner points mentioned in lines 1 and 2 above were in conformance with regulations and rules therefore as required in the current manual of survey instructions of the United States Department of the Interior, Bureau of Land Management or by a decree of a Court of Law and/or that the corner points mentioned in lines 3, 4 and 5 above were in conformance with the rules of the Michigan Board of Land Surveyors or by a Decree of a Court of Law; established, re-established, monumented, recovered, found as expressed below:

NOTE: Not more than 2 corners, all in the same town and range, may be recorded on this certificate.

NOTE: THIS CORNER IS ALSO DESIGNATED C-13, T37N-R3W.


	A	B	C	D	E	F	G	H	I	J	K	L	M
1			●										
2	6		5		4		3		2		1		
3													
4	7		8		9		10		11		12		
5													
6	18		17		16		15		14		13		
7													
8	19		20		21		22		23		24		
9													
10	30		29		28		27		26		25		
11													
12	31		32		33		34		35		36		
13													

A. Description of original monument and accessories and/or subsequent restoration:

1840 John Mullett Original Survey Set section post 10" Beech N 13° W 13 lks (8.58') 12" Beech N 55° E 44 lks (29.04')	Sept. 1976 Herbert Fluharty #18223 Set 5/8" X 18" Re-rod w/cap equidistant on line between N 1/4 Cor. Sec. 6 & NE Cor. Sec 5, Support pole S 23° E 54.00' T.P. S 52° W 60.03'	P.P. N 28° E 51.24' 8' ± N of E-W Road, 15' ± E of road to N, 8' ± W of centerline Woods Rd to South
---	---	---

B. Description of corner evidence found and/or method applied in restoring or reestablishing corner:

Fnd 5/8" re-rod w/unreadable Cap Under Asphalt Road 8' +/- North Centerline E-W Road 15' +/- East Centerline Road to North 8' +/- West Centerline Wood Road to South	P. Pole w/Nail Cut off at ground S 23° E 53.80' T. Pole 4' High S 52° W 59.95' w/nail P. Pole #1590 N 35° E 54.90' Guy Pole S 25° E 56.79' 8" Hemlock S 7° W 81.73'
--	---

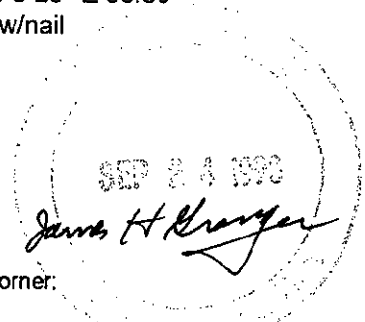

C. Description of monument for corner and accessories established to perpetuate locating the position of the corner:

C-1 Placed remonumentation cap on 5/8" rebar in monument box, and position is accepted as a careful and faithful perpetuation of the original corner.

P. Pole Cut off at grade S 23° E 53.80'	w/nail
T. Pole 4' High S 52° W 59.95'	w/nail
P. Pole #1590 N 35° E 54.90'	Set tag 41099
Guy Pole S 25° E 56.79'	Set tag 41099
8" Hemlock S 7° W 81.73'	Set tag 41099

NOTE: THIS CORNER IS ALSO DESIGNATED CODE C-13 IN T37N-R3W.



Signed by B. K. Fullford
 Surveyor's Michigan License No. 41099

Date 11/23/98