RECEIVED
FOR RECORD
00 JAN -3 PM 12: 57
Vicky Pyzynski
CLERK/REGISTER
CHEBOYGAN COUNTY MICHIGAN

1999 CHEBOYGAN COUNTY REMONUMENTATION

LAND CORNER RECORDATION CERTIFICATE

Filing Requirement of Act 74, Mich. P.A. 1970

For corners in Cheboygan (County)

	Located In:	Corner Code #
1. Public Land Survey	T36N R3W	C-4
	T___ R___	
	T___ R___	
	T___ R___	
2. Property Controlling in Section	S___ T___ R___	
	S___ T___ R___	
3. Miscellaneous Property in Sec.	S___ T___ R___	
	S___ T___ R___	

MAR 03 2000

Register of Deeds Stamp & File Number

SECTION

4. Lot No. _____, Recorded Plat _____
5. Private Claims _____

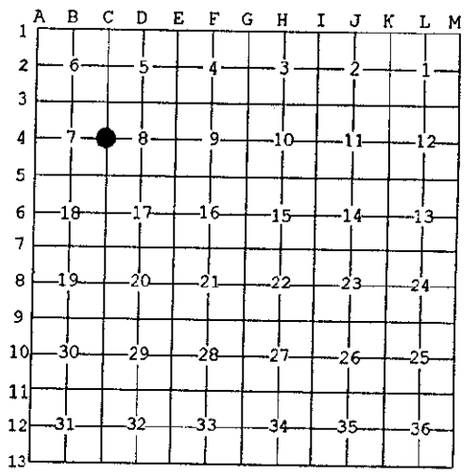

I, Brian K. Fullford, in a field survey on August, 1999 do hereby state that under requirements of P.A. 74, Michigan P.A. of 1970, the corner points mentioned in lines 1 and 2 above were in conformance with regulations and rules therefore as required in the current manual of survey instructions of the United States Department of the Interior, Bureau of Land Management or by a decree of a Court of Law and /or that the corner points mentioned in lines 3, 4 and 5 above were in conformance with the rules of the Michigan Board of Land Surveyors or by a Decree of a Court of Law; established, re-established, monumented, recovered, found as expressed below:

NOTE: **Not more than 2 corners, all in the same town and range, may be recorded on this certificate.**

A. Description of original monument and accessories and/or subsequent restoration:

Resurvey 1855
Found old ¼ Sec. Cor.
16" Beech N33°E 16 Lks.
12" Beech N3°W 13 Lks.

1976 Doyle
Rls. #7319
Set Conc. Mon. w/U of M Cap #7319

Mar 95 J. Granger Rls. #16041
Found Conc. Mon w/U of M Cap #7319
4" Maple N38°W 46.44'
8" Poplar S44°W 29.66'
6" Poplar S11°E 42.28'
6" Maple S51°E 33.03'

B. Description of corner evidence found and/or method applied in restoring or reestablishing corner:

Fnd Conc. Mon w/U of M Cap
7" Oak N38°W 46.50' No tag
14" Poplar S44°W 28.16' No tag
9" Poplar S11°E 42.51' No tag
10" Oak S51°E 33.20' No tag

Cheboygan County
OCT 7 1999
James H. Granger
Registered Land Surveyor

C. Description of monument for corner and accessories established to perpetuate locating the position of the corner:

C-4 Use existing concrete monument with U of M cap RLS #7319. Position is accepted as a careful and faithful perpetuation of the original corner.

Guy Pole S41°E 39.91'	Set tag 41099
P. Pole w/trans S37°W 40.47'	Set tag 41099
Guy Pole N44°W 33.25'	Set tag 41099
9" Poplar S14°E 42.28'	Set tag 41099
7" Oak N38°W 46.50'	
14" Poplar S44°W 28.16'	
10" Oak S 51° E 33.20'	

STATE OF MICHIGAN
BRIAN K. FULLFORD
PROFESSIONAL SURVEYOR
No. 41099
LICENSED PROFESSIONAL SURVEYOR

Signed by Brian K. Fullford
Surveyor's Michigan License No. 41099

Date 12/17/99

LIBER 011 PAGE 198

FORM APPROVED BY MICHIGAN STATE BOARD OF PROFESSIONAL SURVEYORS, JAN. 28, 1971
REVISED MAY 14, 1975
REVISED JAN., 1983
REVISED OCT., 1995