

RECEIVED FOR RECORD

1999 CHEBOYGAN COUNTY REMONUMENTATION 00 JAN -3 PM 12: 59
LAND CORNER RECORDATION CERTIFICATE
Filing Requirement of Act 74, Mich. P.A. 1970


Willy Agypinski
CLERK/REGISTER
CHEBOYGAN COUNTY MICHIGAN

| For corners in Cheboyan (County) | Located in: | Corner Code # |
|------------------------------------|----------------------------------|---------------|
| 1. Public Land Survey | T ^{36N} R ^{3W} | C-5 |
| | T R | |
| | T R | |
| | T R | |
| 2. Property Controlling in Section | S T R | |
| | S T R | |
| 3. Miscellaneous Property in Sec. | S T R | |
| | S T R | |

MAR 03 2000

SECTION of Deeds Stamp & File Number

- 4. Lot No. _____, Recorded Plat _____
- 5. Private Claims _____

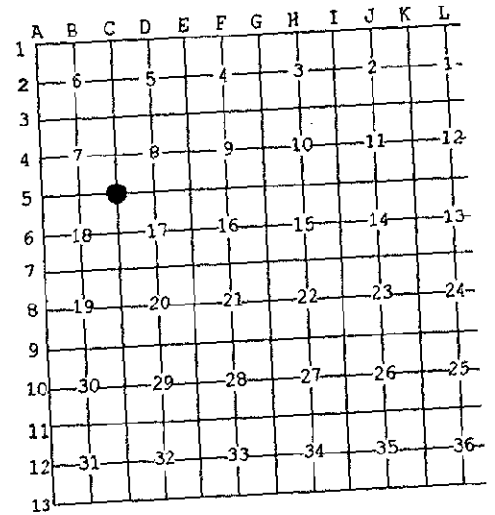

I, Brian K. Fullford, in a field survey on August, 1999 do hereby state that under requirements of P.A. 74, Michigan P.A. of 1970, the corner points mentioned in lines 1 and 2 above were in conformance with regulations and rules therefore as required in the current manual of survey instructions of the United States Department of the Interior, Bureau of Land Management or by a decree of a Court of Law and/or that the corner points mentioned in lines 3, 4 and 5 above were in conformance with the rules of the Michigan Board of Land Surveyors or by a Decree of a Court of Law; established, re-established, monumented, recovered, found as expressed below:


NOTE: Not more than 2 corners, all in the same town and range, may be recorded on this certificate.

A. Description of original monument and accessories and/or subsequent restoration:

| | | |
|-----------------------------|-----------------------------|-----------------------------|
| Resurvey 1855 | Mar. 1950 O. Doyle | Sept. 77 O. Doyle |
| Fnd. old Cor. Post | Rls. #7319 | Rls. #7319 |
| 14" Hemlock S59°E 69 Lks. | Fnd. 3/4" pipe in road | Found 3/4" pipe |
| 16" Beech N47 1/2°W 88 Lks. | Fence post South 38.52' | P. Pole #10990 N38°W 33.73' |
| | 8" Tw. Basswood N30°W 53.0' | 13" Maple S31°E 45.68' |
| | | 8" Tw. Maple S49°W 57.09' |

B. Description of corner evidence found and/or method applied in restoring or reestablishing corner:

Fnd 3/4" pipe 1.8' North of centerline of Road
Centerline of 2 track to North @ 5.1' +/- West
24" Basswood N28°W 53.0' No tag
P. Pole #10990 N39°W 33.65' with old square tag
15" Maple S27°E 45.66' No tag
11" Tw. Maple S47°W 57.03' No tag

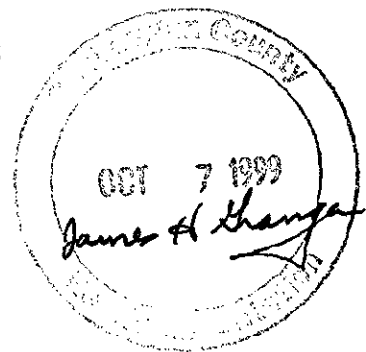

C. Description of monument for corner and accessories established to perpetuate locating the position of the corner:

C-5 Set 5/8" X 36" iron bar & remonumentation cap inside 3/4" pipe. Position is accepted as a careful and faithful perpetuation of the original corner.

15" Maple S27°E 45.66' Set tag 41099
11" Tw. Maple S47°W 57.03' Set tag 41099
P. Pole #10990 N39°W 33.65' Set tag 41099
24" Basswood N28°W 52.80' Set tag 41099



Signed by *B. K. Fullford*
Surveyor's Michigan License No. 41099

Date 12/17/99