

**1999 CHEBOYGAN COUNTY REMONUMENTATION  
LAND CORNER RECORDATION CERTIFICATE  
Filing Requirement of Act 74, Mich. P.A. 1970**

RECEIVED  
FOR RECORD

00 JAN -3 PM 12:55

For corners in  
Cheboygan

	Located In:	Corner Code #
(County)		
1. Public Land Survey	T <u>36N</u> R <u>3W</u>	C-7
	T _____ R _____	_____
	T _____ R _____	_____
	T _____ R _____	_____
2. Property Controlling in Section	S _____ T _____ R _____	_____
	S _____ T _____ R _____	_____
3. Miscellaneous Property in Sec.	S _____ T _____ R _____	_____
	S _____ T _____ R _____	_____

*Vicky Pyszynski*  
CLERK/REGISTER  
CHEBOYGAN COUNTY MICHIGAN

MAR 03 2000

SECTION  
Register of Deeds Stamp & File Number

4. Lot No. \_\_\_\_\_, Recorded Plat \_\_\_\_\_

5. Private Claims \_\_\_\_\_


I, Brian K. Fullford, in a field survey on Sept., 1999 do hereby state that under requirements of P.A. 74, Michigan P.A. of 1970, the corner points mentioned in lines 1 and 2 above were in conformance with regulations and rules therefore as required in the current manual of survey instructions of the United States Department of the Interior, Bureau of Land Management or by a decree of a Court of Law and /or that the corner points mentioned in lines 3, 4 and 5 above were in conformance with the rules of the Michigan Board of Land Surveyors or by a Decree of a Court of Law; established, re-established, monumented, recovered, found as expressed below:

NOTE: Not more than 2 corners, all in the same town and range, may be recorded on this certificate.

	A	B	C	D	E	F	G	H	I	J	K	L	M
1													
2	6		5		4		3		2		1		
3													
4	7		8		9		10		11		12		
5													
6	18		17		16		15		14		13		
7													
8	19		20		21		22		23		24		
9													
10	30		29		28		27		26		25		
11													
12	31		32		33		34		35		36		
13													

- A. Description of original monument and accessories and/or subsequent restoration:**
- |                              |                                 |                        |                          |
|------------------------------|---------------------------------|------------------------|--------------------------|
| Resurvey 1855                | Mar. 1992 J. Granger            | June 1994 J. Granger   | Jan 1998                 |
| Found old 1/4 Sec. Cor.      | Rls #16041                      | Rls 16041              | J. Granger               |
| 6" Beech N65°W 9 Lks.        | Fnd 3/4" pipe w/5/8" rod inside | Found 3/4" pipe        | Rls 16041                |
| 10" Beech N70°E 33 Lks.      | 8" Beech S40°W 14.35'           | 12" Beech N53°E 28.53' | Found 3/4" pipe as       |
|                              | 6" Maple N15°W 10.11'           | 8" Beech S40°W 14.35'  | recorded in Liber 2, Pg. |
| Mar. 1950 O. Doyle Rls #7319 | 12" Beech N53°E 28.53'          | 6" Maple N15°W 10.11'  | 175                      |
| Found 5/8" rod in 3/4" pipe  | 4" Maple S57°E 20.14'           | 4" Maple S57°E 20.14'  |                          |
| 8" Maple S40°30'W 26.95'     |                                 |                        |                          |
| 10" Maple S85°45'W 42.35'    |                                 |                        |                          |

- B. Description of corner evidence found and/or method applied in restoring or reestablishing corner:**
- Fnd 3/4" pipe w/5/8" bar inside 7' West of N-S 2 track  
 Old fence line to North and East  
 5" Sq. & scribed cedar post N45°W @ 1.50' old 2 track to east  
 30" Tw. Maple S40°30'W 26.9' No tag  
 24" Maple S85°45'W 42.4' No tag  
 10" Tw. Maple S62°E 20.7' No tag  
 8" Cherry S32°W 14.32' with tag 16041  
 10" Maple N17°W 10.09' No tag

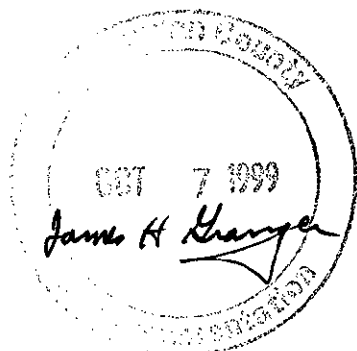

- C. Description of monument for corner and accessories established to perpetuate locating the position of the corner:**
- C-7 Set remonumentation cap on 5/8" bar inside 3/4" pipe. Position is accepted as a careful and faithful perpetuation of the original corner.

- 12" Cherry N49°E 28.80' Set tag 41099
- 10" Tw. Maple S62°E 20.74' Set tag 41099
- 8" Cherry S32°W 14.32 w/tag 16041
- 10" Maple N17°W 10.09' Set tag 41099



Signed by B. K. Fullford  
 Surveyor's Michigan License No. 41099

Date 12/17/99