

RECEIVED FOR RECORD

1999 CHEBOYGAN COUNTY REMONUMENTATION 00 JAN -3 PM 12: 51

LAND CORNER RECORDATION CERTIFICATE
Filing Requirement of Act 74, Mich. P.A. 1970

Cheryl Pyszynski

CLEK/REGISTER
CHEBOYGAN COUNTY MICHIGAN

MAR 03 2000

Register of Deeds Stamp & File Number
SECTION

For corners in
Cheboygan

Located In:

Corner Code #

(County)

1. Public Land Survey

36N 3W C-8
T R
T R
T R
T R

2. Property Controlling
in Section

S T R
S T R
S T R
S T R

3. Miscellaneous
Property in Sec.

4. Lot No. _____, Recorded Plat _____
5. Private Claims _____

I, Brian K. Fullford, in a field survey on Sept., 1999 do hereby state that under requirements of P.A. 74, Michigan P.A. of 1970, the corner points mentioned in lines 1 and 2 above were in conformance with regulations and rules therefore as required in the current manual of survey instructions of the United States Department of the Interior, Bureau of Land Management or by a decree of a Court of Law and /or that the corner points mentioned in lines 3, 4 and 5 above were in conformance with the rules of the Michigan Board of Land Surveyors or by a Decree of a Court of Law; established, re-established, monumented, recovered, found as expressed below:

NOTE: Not more than 2 corners, all in the same town and range, may be recorded on this certificate.

	A	B	C	D	E	F	G	H	I	J	K	L	M
1													
2	6		5		4		3		2		1		
3													
4	7		8		9		10		11		12		
5													
6	18		17		16		15		14		13		
7													
8	19		20		21		22		23		24		
9													
10	30		29		28		27		26		25		
11													
12	31		32		33		34		35		36		
13													

A. Description of original monument and accessories and/or subsequent restoration:

Resurvey
1855
9" Cedar on corner
10" B. Ash S14°W 10 Lks.

Mar. 1950 O. Doyle
Rls. 7319
Found 6" Cedar stake w/1/2" pipe alongside
6" Elm S11°W 39.5'
6" Tw. Elm S20°E 40.85'

B. Description of corner evidence found and/or method applied in restoring or reestablishing corner:


Find 1/2" pipe w/6" sq. & scribed cedar post
Cor. is 149' North +/- of centerline Indian Trail Road



C. Description of monument for corner and accessories established to perpetuate locating the position of the corner:

C-8 Set 5/8" X 3/8" iron bar & remonumentation cap over 1/2" pipe. Position is accepted as a careful and faithful perpetuation of the original corner.

7" Tw. Swamp Ash S20°E 34.58' Set tag 41099
Set steel fence post South 63.10'
Set steel fence post N77°W 9.80'
Set steel fence post N8°W 20.57'

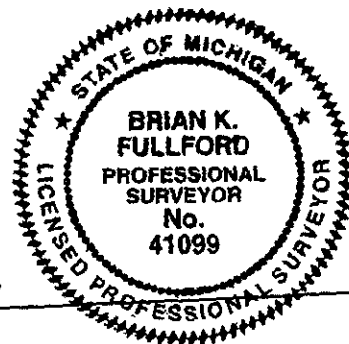

Signed by *Brian K. Fullford*
Surveyor's Michigan License No. 41099

Date 12/17/99