

RECEIVED FOR RECORD

1999 CHEBOYGAN COUNTY REMONUMENTATION 00 JAN -3 PM 12:49

LAND CORNER RECORDATION CERTIFICATE Filing Requirement of Act 74, Mich. P.A. 1970

For corners in Cheboygan

Table with columns: (County), Located In, Corner Code #. Rows include Public Land Survey, Property Controlling in Section, and Miscellaneous Property in Sec.

Handwritten signature and title: CLERK/REGISTER CHEBOYGAN COUNTY MICHIGAN

MAR 03 2000


SECTION

Register of Deeds Stamp & File Number

4. Lot No. , Recorded Plat 5. Private Claims

Brian K. Fullford in a field survey on Sept. 1999 do hereby state that under requirements of P.A. 74, Michigan P.A. of 1970, the corner points mentioned in lines 1 and 2 above were in conformance with regulations and rules therefore as required in the current manual of survey instructions of the United States Department of the Interior, Bureau of Land Management or by a decree of a Court of Law and/or that the corner points mentioned in lines 3, 4 and 5 above were in conformance with the rules of the Michigan Board of Land Surveyors or by a Decree of a Court of Law; established, re-established, monumented, recovered, found as expressed below:

NOTE: Not more than 2 corners, all in the same town and range, may be recorded on this certificate.

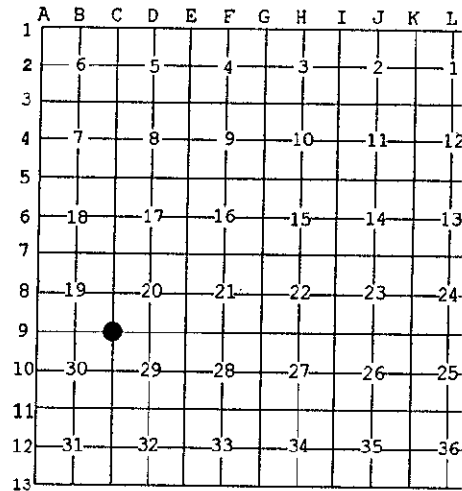


A. Description of original monument and accessories and/or subsequent restoration:

- List of survey details including Resurvey 1855, Plat of Chickagami Shores, Plat of Maple Bay Woods, 10" Cedar S70°E 10 Lks., 9" Cedar N19°W 17 Lks., Jan. 1962 D. Delamater Rls. 5778, Oct. 1973 G. Young Rls. 10710, Mar. 1989 J. Young Rls. 24626, May 1950 O. Doyle Rls. #7319, Set 1/2" X 24" T-iron, Plat of Burt Lake View, Fnd 5/8" Rod, P. Pole S77°W 179.6', No witnesses given, P. Pole S35 1/2°E 38.7', Mar. 1989 R. Bidstrup Rls. 11360, June 1956 T. Schweigert Rls. 6525, Apr. 1965 G. Young Rls. 10710, Fnd 1 1/4" bolt in Mon. box, 8" P. Pole S32°E 38.85', Oct. 93 J. Granger Rls. 16041, Fnd 1 1/4" Hex. bolt as rec. in Liber 2, Pg. 50

B. Description of corner evidence found and/or method applied in restoring or reestablishing corner:

Fnd 1 1/2" Hexagonal bolt in Mon. box (Mon Box 2" below asphalt w/no lid) P. Pole S32°E 38.85' w/tag 10710 P. Pole S81°W 179.73' w/cap 24626 T. Pole N11°W 33.57' w/tag 10710

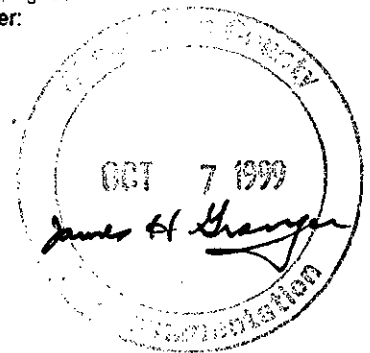

C. Description of monument for corner and accessories established to perpetuate locating the position of the corner:

C-9 Replaced 1 1/2" Hexagonal bolt with 5/8" X 36" iron bar and remonumentation cap and set new monument box. Position is accepted as a careful and faithful perpetuation of the original corner. 12" Aspen N37°E 57.17' Set tag 41099 P.Pole S32°E 38.85' w/tag 10710 P.Pole S81°W 179.73' w/cap 24626 T. Pole N11°W 33.57' w/tag 10710

Signed by [Signature] Surveyor's Michigan License No. 41099

Date 12/27/99

