RECEIVED FOR RECORD
00 JAN -3 PM 12: 53
Vicky Szczygielski
CLERK/REGISTER
CHEBOYGAN COUNTY MICHIGAN

1999 CHEBOYGAN COUNTY REMONUMENTATION

LAND CORNER RECORDATION CERTIFICATE

Filing Requirement of Act 74, Mich. P.A. 1970

For corners in Cheboygan (County)

	Located In:	Corner Code #
1. Public Land Survey	T36N R3W	D-5
	T___ R___	
	T___ R___	
	T___ R___	
2. Property Controlling	S___ T___ R___	
in Section	S___ T___ R___	
3. Miscellaneous	S___ T___ R___	
Property in Sec.	S___ T___ R___	

MAR 03 2000

SECTION

Register of Deeds Stamp & File Number

4. Lot No. _____ , Recorded Plat _____

5. Private Claims _____

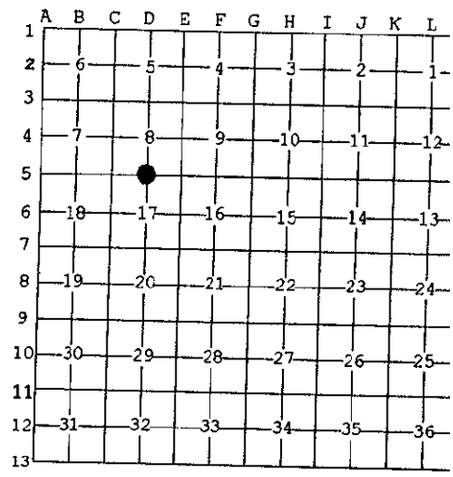

I, Brian K. Fullford, in a field survey on August, 19 99 do hereby state that under requirements of P.A. 74, Michigan P.A. of 1970, the corner points mentioned in lines 1 and 2 above were in conformance with regulations and rules therefore as required in the current manual of survey instructions of the United States Department of the Interior, Bureau of Land Management or by a decree of a Court of Law and /or that the corner points mentioned in lines 3, 4 and 5 above were in conformance with the rules of the Michigan Board of Land Surveyors or by a Decree of a Court of Law; established, re-established, monumented, recovered, found as expressed below:

NOTE: **Not more than 2 corners, all in the same town and range, may be recorded on this certificate.**

A. **Description of original monument and accessories and/or subsequent restoration:**

Resurvey 1855
Set Post
20" Hemlock S55°E 33 Lks.
16" Beech N42°W 7 Lks.

July 1953 O. Doyle Rls. #7319
Set ¾" pipe
24" Elm N10°W 30.41'
40" Tw. Basswood S70°30'W 75.17'
26" Hemlock S9°30'W 73.33'
18" Maple stump S24°W w/old marks

Nov. 1966 Schweigert & Young
Fnd 1" iron pipe
No witnesses given

June 1972 G. Young
Rls. 10710
Fnd 1" pipe in road center line
No witnesses given

Nov. 1980 J. Green Rls. 15401
Fnd ¾" pipe
40" Tw. Basswood S73°W 76.91'
P. Pole N4°E 30.00'
9" Y. Birch S61°W 40.83'
10" Ash S18° W 33.14'

Nov. 1990 R. Oelke Rls. 33983
Fnd ¾" rod
12" Y. Birch S54°W 40.83'
12" Ash S12°W 33.25'
P. Pole N0°E 30.05'
40" Basswood S64°W 76.91'

Feb. 1991 N. DeYoung
Rls. 20705
Unknown
No witness given

Aug. 1995 M. Trowbridge Rls. 27463
Fnd ¾" pipe
40" Tw. Basswood S73°W 76.91'
P. Pole N4°E 30.00'
9" Y. Birch S61°W 40.83'
10" Ash S18°W 33.17'

B. **Description of corner evidence found and/or method applied in restoring or reestablishing corner:**

Fnd ¾" pipe in road centerline 48' +/- West of road intersection
P.Pole N4°E 30.05' w/tag 15401
30" Hemlock S13°W 72.8' No tag
18" Ash S21°W 33.0' No tag
18" Y. Birch S63°W 39.8' No tag
40" Tw. Basswood S75°W 76.91' with tag 15401

OCT 7 1999

C. **Description of monument for corner and accessories established to perpetuate locating the position of the corner:**

D-5 Set 5/8" X 36" iron bar and remonumentation cap over ¾" pipe. Position is accepted as a careful and faithful perpetuation of the original corner.

18" Ash S21°W 32.97' Set tag 41099
18" Y. Birch S63°W 39.84' Set tag 41099
40" Tw. Basswood S75°W 76.91' w/ tag 15401
P. Pole N4°E 30.05' with tag 15401

STATE OF MICHIGAN
BRIAN K. FULLFORD
PROFESSIONAL SURVEYOR
No. 41099
LICENSED PROFESSIONAL SURVEYOR

Signed by B. K. Fullford

Surveyor's Michigan License No. 41099

Date 12/17/99

LIBER 011 PAGE 194

FORM APPROVED BY MICHIGAN STATE BOARD OF PROFESSIONAL SURVEYORS, JAN. 28, 1971
REVISED MAY 14,1975
REVISED JAN., 1983
REVISED OCT., 1995