

RECEIVED FOR RECORD

00 JAN -3 PM 12: 54

1999 CHEBOYGAN COUNTY REMONUMENTATION LAND CORNER RECORDATION CERTIFICATE Filing Requirement of Act 74, Mich. P.A. 1970

*Dickie Pyzyrski*

CLERK/REGISTER CHEBOYGAN COUNTY MICHIGAN

For corners in Cheboygan

Table with columns: Located In: (County), Corner Code #, and survey details (1. Public Land Survey, 2. Property Controlling in Section, 3. Miscellaneous Property in Sec.)

Register of Deeds Stamp & File Number. Includes date MAR 03 2000 and SECTION information.

4. Lot No. \_\_\_\_\_, Recorded Plat \_\_\_\_\_
5. Private Claims \_\_\_\_\_

I, Brian K. Fullford, in a field survey on Sept. 1999 do hereby state that under requirements of P.A. 74, Michigan P.A. of 1970, the corner points mentioned in lines 1 and 2 above were in conformance with regulations and rules therefore as required in the current manual of survey instructions of the United States Department of the Interior, Bureau of Land Management or by a decree of a Court of Law and/or that the corner points mentioned in lines 3, 4 and 5 above were in conformance with the rules of the Michigan Board of Land Surveyors or by a Decree of a Court of Law; established, re-established, monumented, recovered, found as expressed below:

Grid table with columns A-M and rows 1-13. A dot is marked at row 7, column D.


NOTE: Not more than 2 corners, all in the same town and range, may be recorded on this certificate.

A. Description of original monument and accessories and/or subsequent restoration:

- List of survey details including Resurvey 1855, May 1950 O. Doyle, Oct. 1972 G. Young Rls, Dec. 1995 J. Granger Rls 16041, Job #41-48 Doyle Eng., Job #102-66 Doyle Eng., Sept. 1990 R. Dunn Rls, Mar. 1997 M. Trowbridge.

B. Description of corner evidence found and/or method applied in restoring or reestablishing corner:


Fnd 3/4" pipe
18" Ash N66°W 43.63' with small nail

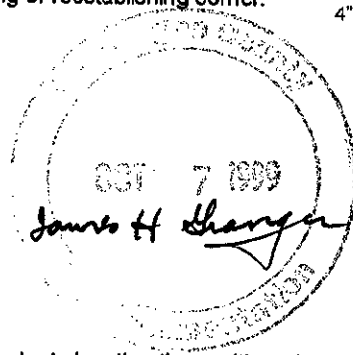

C. Description of monument for corner and accessories established to perpetuate locating the position of the corner:

D-7 Set 5/8" X 36" iron bar and remonumentation cap over 3/4" pipe. Position is accepted as a careful and faithful perpetuation of the original corner.

- 18" Ash N66°W 43.63' Set tag 41099
4" Cedar S71°E 17.85' w/tag 28417
24" Tw. Maple N38°W 62.87' Set tag 41099
SW corner garage foundation Hse #3038 N21°E 27.27'

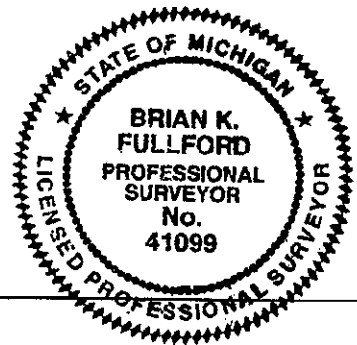

Signed by *B. K. Fullford*
Surveyor's Michigan License No. 41099

Date 12/17/99