

RECEIVED FOR RECORD

1999 CHEBOYGAN COUNTY REMONUMENTATION  
LAND CORNER RECORDATION CERTIFICATE  
Filing Requirement of Act 74, Mich. P.A. 1970

*Willy Pyszynski*

CLERK/REGISTER  
CHEBOYGAN COUNTY MICHIGAN

MAR 03 2000

SECTION

Register of Deeds Stamp & File Number

For corners in  
Cheboygan

Located In: Corner Code #

1. Public Land Survey

T<sup>36N</sup> R<sup>3W</sup> D-9

2. Property Controlling  
in Section

S T R

3. Miscellaneous  
Property in Sec.

S T R

4. Lot No. \_\_\_\_\_, Recorded Plat \_\_\_\_\_

5. Private Claims \_\_\_\_\_

I, Brian K. Fullford, in a field survey on December, 1999, do hereby state that under requirements of P.A. 74, Michigan P.A. of 1970, the corner points mentioned in lines 1 and 2 above were in conformance with regulations and rules therefore as required in the current manual of survey instructions of the United States Department of the Interior, Bureau of Land Management or by a decree of a Court of Law and /or that the corner points mentioned in lines 3, 4 and 5 above were in conformance with the rules of the Michigan Board of Land Surveyors or by a Decree of a Court of Law, established, re-established, monumented, recovered, found as expressed below:

NOTE: Not more than 2 corners, all in the same town and range, may be recorded on this certificate.


A	B	C	D	E	F	G	H	I	J	K	L	M
1												
2	6	5	4	3	2	1						
3												
4	7	8	9	10	11	12						
5												
6	18	17	16	15	14	13						
7												
8	19	20	21	22	23	24						
9												
10	30	29	28	27	26	25						
11												
12	31	32	33	34	35	36						
13												

A. Description of original monument and accessories and/or subsequent restoration:

Resurvey 1855 Fnd old post 14" Beech N62°W 35 Lks. 9" Sugar Maple N14°E 36 Lks.	Jan. 1962 D. Delamater Rls. 5778 Set 1/2" X 24" T-iron P. Pole S48°E 38.4' T. Pole N8°W 28.7'	Oct. 1973 G. Young Rls. 10710 Plat of Burt Lake View Sub No witnesses given	Mar. 1989 J. Young Rls. 24626 Fnd 1/2" iron rod P. Pole S47°E 45.78' 16" Maple S56°W 74.43' T. Pole N10°W 38.35'
May 1950 O. Doyle Rls. 7319 Fnd 1" pipe in Rd. centerline Steel fence to South	Job #34-63 Doyle Engineers Fnd unknown No witnesses given	Sept. 1988 R. Bistrup Rls. 11360 Fnd 1/2" rod 8" P. Pole S47°E 45.78' 16" Maple S56°W 74.73' 6" T. Pole N10°W 38.35'	Oct. 93 J. Granger Rls. 16041 Fnd 1/2" iron as recorded in Liber 2, Pg. 50
June 1956 T. Schweigert Rls. 6525 Plat of Chickagami Shores No witnesses given			

B. Description of corner evidence found and/or method applied in restoring or reestablishing corner:

1" pipe fnd  
T.Pole S31°E 37.87' with tag 10710  
30" Maple S60°W 86.93' with cap 24626  
P. Pole N29°W 41.78' with tag 10710  
Rusty nail West 13.82'  
Steel fence to South

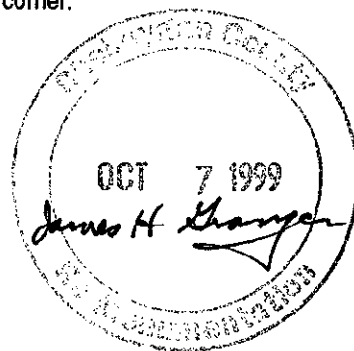

C. Description of monument for corner and accessories established to perpetuate locating the position of the corner:

D-9 Set remonumentation cap on 5/8" X 36" iron bar in monument box. Position is accepted as a careful and faithful perpetuation of the original corner.  
4" Steel fence post to South 36.0' to base of old fence to the South  
Rusted Nail West 13.82'  
Two-track to North 6' East  
18" W. Pine N48°E 66.94' Set tag 41099  
T. Pole S31°E 37.87' with tag 10710  
30" Maple S60°W 86.93' with cap 24626  
P. Pole N29°N 41.78' with tag 10710



Signed by B. K. Fullford  
Surveyor's Michigan License No. 41099

Date 12/20/99