

SECTION

1998
CHEBOYGAN COUNTY REMONUMENTATION
LAND CORNER RECORDATION CERTIFICATE
Filing Requirement of Act 74, Mich. P.A. 1970

For corners in
Cheboygan

(County)	Located In:	Corner Code #
1. Public Land Survey	36N R 3W	E-3
	T R	
	T R	
	T R	
	T R	
2. Property Controlling in Section	S T R	
	S T R	
3. Miscellaneous Property in Sec.	S T R	
	S T R	

RECEIVED FOR RECORD 1-8-99
at 9:02 O'Clock A M

James H. Granger


CLERK/REGISTER
CHEBOYGAN COUNTY, MICHIGAN

Register of Deeds Stamp & File Number

4. Lot No. _____, Recorded Plat _____
5. Private Claims _____

I, Brian K. Fullford, in a field survey on June, 1998 do hereby state that under requirements of P.A. 74, Michigan P.A. of 1970, the corner points mentioned in lines 1 and 2 above were in conformance with regulations and rules therefore as required in the current manual of survey instructions of the United States Department of the Interior, Bureau of Land Management or by a decree of a Court of Law and/or that the corner points mentioned in lines 3, 4 and 5 above were in conformance with the rules of the Michigan Board of Land Surveyors or by a Decree of a Court of Law; established, re-established, monumented, recovered, found as expressed below:

NOTE: Not more than 2 corners, all in the same town and range, may be recorded on this certificate.

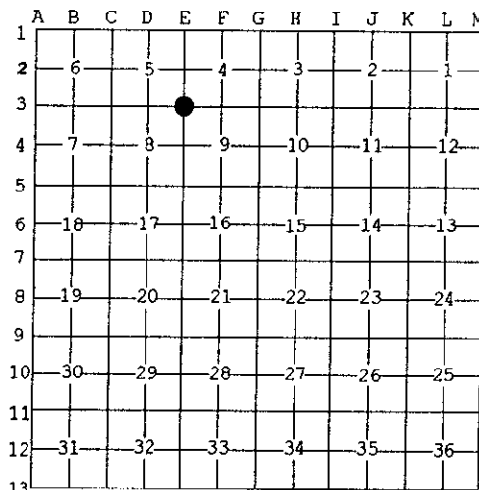

A. Description of original monument and accessories and/or subsequent restoration:

1855	1970	April 1994
Harvey Mellon	Doyle Civil Eng.	James Granger
Resurvey	#7319	#16041
Set post	Fnd Conc Mon.	Fnd Conc Mon
10" Cedar N 71° E 38 lks (25.08')	6" Cedar N 63° W 13.97'	14" Cedar N 2° E 27.25' w/tag 33983
9" Cedar N 16° W 10 lks (6.60')	14" Cedar N 85° E 8.41'	12" Cedar S 32° W 9.93' w/tag 33983
	10" Cedar S 37° W 10.64'	12" Cedar S 37° E 13.41'
		8" Cedar S 73° E 12.73'

*See continuation of A on reverse side

B. Description of corner evidence found and/or method applied in restoring or reestablishing corner:

Fnd Conc Mon w/U of M cap RLS #7319
15" Cedar N 2° E 27.13' w/tag 33983
14" Cedar S 32° W 9.93' w/tag 33983
13" Cedar S 37° E 13.28' w/tag 16041
8" Cedar S 73° E 12.62' w/tag 16041
33.5' +/- South of Centerline drive

James H. Granger

C. Description of monument for corner and accessories established to perpetuate locating the position of the corner:

E-3 Use existing concrete monument with U of M cap RLS #7319, and position is accepted as a careful and faithful perpetuation of the original corner.

15" Cedar N 2° E 27.13'	w/tag 33983
14" Cedar S 32° W 9.93'	w/tag 33983
13" Cedar S 37° E 13.28'	w/tag 16041
8" Cedar S 73° E 12.62'	w/tag 16041
33.5' +/- South of Centerline drive	



Signed by *B. K. Fullford*
Surveyor's Michigan License No. 41099

Date 11/23/98

SURVEY &
RECONUMENTATION

MAR 28 1999

SECTION

A. Continued:

June 1994
James Granger
#16041
Fnd Conc Mon w/U of M cap & RLS #7319
14" Cedar N 2° E 27.25'
12" Cedar S 32° W 9.93'
12" Cedar S 37° E 13.41;
8" Cedar S 73° E 12.73'
8" Cedar S 73° E 12.73'

March 1995
James Granger
#16041
Fnd Conc Mon w/U of M cap & RLS #7319
14" Cedar N 2° E 27.25' Fnd tag
12" Cedar S 32° W 9.93' Fnd tag
12" Cedar S 37° E 13.41'

Fil Wade Trini

9
2
CR ~~5263~~
5509