

1999

1998
CHEBOYGAN COUNTY REMONUMENTATION
LAND CORNER RECORDATION CERTIFICATE
Filing Requirement of Act 74, Mich. P.A. 1970

SECTION

For corners in
Cheboygan
(County)

Located In: Corner Code #

1. Public Land Survey	T <u>36</u> N R <u>3</u> W	<u>F-1</u>
	T <u>37</u> N R <u>3</u> W	<u>F-13</u>
	T ___ R ___	_____
	T ___ R ___	_____
2. Property Controlling in Section	S ___ T ___ R ___	_____
	S ___ T ___ R ___	_____
3. Miscellaneous Property in Sec.	S ___ T ___ R ___	_____
	S ___ T ___ R ___	_____

RECEIVED FOR RECORD 1-8-99
at 9:05 O'Clock A.M

Jeanne Spay

CLERK/REGISTER
CHEBOYGAN COUNTY, MICHIGAN

Register of Deeds Stamp & File Number

4. Lot No. _____, Recorded Plat _____
5. Private Claims _____

I, Brian K. Fullford, in a field survey on June, 1998 do hereby state that under requirements of P.A. 74, Michigan P.A. of 1970, the corner points mentioned in lines 1 and 2 above were in conformance with regulations and rules therefore as required in the current manual of survey instructions of the United States Department of the Interior, Bureau of Land Management or by a decree of a Court of Law and /or that the corner points mentioned in lines 3, 4 and 5 above were in conformance with the rules of the Michigan Board of Land Surveyors or by a Decree of a Court of Law, established, re-established, monumented, recovered, found as expressed below:

NOTE: Not more than 2 corners, all in the same town and range, may be recorded on this certificate.


1	A	B	C	D	E	F	G	H	I	J	K	L	M
2		6		5		4		3		2		1	
3													
4		7		8		9		10		11		12	
5													
6		18		17		16		15		14		13	
7													
8		19		20		21		22		23		24	
9													
10		30		29		28		27		26		25	
11													
12		31		32		33		34		35		36	
13													

A. Description of original monument and accessories and/or subsequent restoration:

1840 John Mullett Original Survey Set 1/4 Post 15" Pine N 42° E 16 lks (10.56') 16" Pine N 11° W 25 lks (16.50')	1970 Doyle Civil Engineers #7319 Fnd 1" pipe W. Pine S 26° 30' W 17.88' W. Pine S 75° E 19.57' Maple N 36° 30' E 17.45' Stump N 07° 30' W 16.39'
--	--

B. Description of corner evidence found and/or method applied in restoring or reestablishing corner:

Fnd 1" pipe w/mushroomed top Fnd old burnt moss covered Stump lying down N 42° E 10.3' Fnd Old 16" Burnt stump w/possible Blaze N 13° W 16.0' (old wit)	6" Tw. Maple N 35° E 17.47' w/ old blaze 9" W. Pine S 76° E 19.61' w/ old blaze 8" R. Pine S 24° W 18.19' old wit
---	---

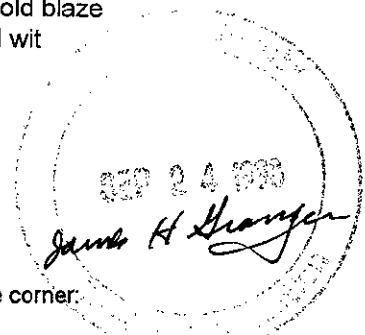

C. Description of monument for corner and accessories established to perpetuate locating the position of the corner:

F-1 Place 5/8" rebar with remonumentation cap inside pipe, and position is accepted as a careful and faithful perpetuation of the original corner.

6" Tw. Maple N 35° E 17.47'	Set tag 41099
9" W. Pine S 76° E 19.61'	Set tag 41099
8" R. Pine S 24° W 18.19'	Set tag 41099
8" R. Pine N 38° W 31.45'	Set tag 41099

NOTE: THIS CORNER IS ALSO DESIGNATED AS CODE F-13 IN T37N-R3W.



Signed by *B. K. Fullford*
Surveyor's Michigan License No. 41099

Date 11/23/98