

SURVEY &
REMONUMENTATION

MAR 22 1999

SECTION

1998
CHEBOYGAN COUNTY REMONUMENTATION
LAND CORNER RECORDATION CERTIFICATE
Filing Requirement of Act 74, Mich. P.A. 1970

For corners in
Cheboygan

(County)

Located In:

Corner Code #

1. Public Land Survey

T 36N R 3W

H-1 ✓

T 37N R 3W

H-13

T R

T R

2. Property Controlling
in Section

S T R

S T R

3. Miscellaneous
Property in Sec.

S T R

S T R

RECEIVED FOR RECORD 1-8-99
at 9:09 O'Clock A M

Joanne Spray

CLERK/REGISTER
CHEBOYGAN COUNTY, MICHIGAN

Register of Deeds Stamp & File Number

4. Lot No. _____, Recorded Plat _____
5. Private Claims _____

I, Brian K. Fullford, in a field survey on June, 1998 do hereby state that under requirements of P.A. 74, Michigan P.A. of 1970, the corner points mentioned in lines 1 and 2 above were in conformance with regulations and rules therefore as required in the current manual of survey instructions of the United States Department of the Interior, Bureau of Land Management or by a decree of a Court of Law and /or that the corner points mentioned in lines 3, 4 and 5 above were in conformance with the rules of the Michigan Board of Land Surveyors or by a Decree of a Court of Law; established, re-established, monumented, recovered, found as expressed below:

NOTE: Not more than 2 corners, all in the same town and range, may be recorded on this certificate.


	A	B	C	D	E	F	G	H	I	J	K	L	M
1													
2	6		5		4		3		2		1		
3													
4	7		8		9		10		11		12		
5													
6	18		17		16		15		14		13		
7													
8	19		20		21		22		23		24		
9													
10	30		29		28		27		26		25		
11													
12	31		32		33		34		35		36		
13													

A. Description of original monument and accessories and/or subsequent restoration:

1840 John Mullett Original Survey Set 1/4 Post 14" Hemlock N 13° W 32 lks 9" Beech N 51° E 42 lks	1970 Doyle Civil Engineers #7319 Fnd 1" pipe 6" Maple S 26° 30' E 16.35' 6" Maple N 34° W 59.45' 4" Maple N 22° E 27.73'
---	---

B. Description of corner evidence found and/or method applied in restoring or reestablishing corner:

Fnd Conc Mon w/U of M cap & RLS #7319
2 track to East, West & North
7" Maple Cluster N 21° E 27.62' old wit

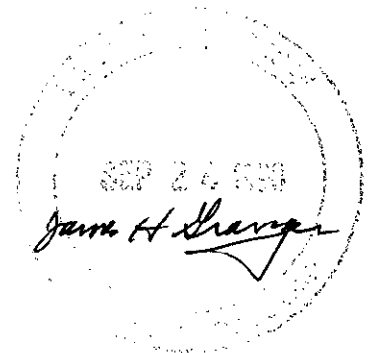

C. Description of monument for corner and accessories established to perpetuate locating the position of the corner:

H-1 Use existing concrete monument with U of M cap & RLS #7319, and position is accepted as a careful and faithful perpetuation of the original corner.

7" Maple Cluster N 21° E 27.62'	Set tag 41099
8" Oak S 71° E 27.15'	Set tag 41099
7" W. Pine S 64° W 20.83'	Set tag 41099
14" Poplar N 52° W 16.83'	Set tag 41099

NOTE: THIS CORNER IS ALSO DESIGNATED CODE H-13 IN T37N-R3W.

Signed by *B. K. Fullford*
Surveyor's Michigan License No. 41099

Date 11/23/98

