

**SURVEY & REMONUMENTATION**

FEB 26 1998

**SECTION**

**CHEBOYGAN COUNTY REMONUMENTATION  
LAND CORNER RECORDATION CERTIFICATE**  
Filing Requirement of Act 74, Mich. P.A. 1970

For corners in

Cheboygan

(County)

Located in:

Corner Code #

- |                                    |                   |            |
|------------------------------------|-------------------|------------|
| 1. Public Land Survey              | <u>T36N R 3W</u>  | <u>I-4</u> |
|                                    | T ___ R ___       | _____      |
|                                    | T ___ R ___       | _____      |
|                                    | T ___ R ___       | _____      |
| 2. Property Controlling in Section | S ___ T ___ R ___ | _____      |
|                                    | S ___ T ___ R ___ | _____      |
| 3. Miscellaneous Property in Sec.  | S ___ T ___ R ___ | _____      |
|                                    | S ___ T ___ R ___ | _____      |

RECEIVED FOR RECORD 12-18-97  
at 11:03 O'Clock A M.

*Joanne Spray*

CLERK/REGISTER  
CHEBOYGAN COUNTY, MICHIGAN

Register of Deeds Stamp & File Number

4. Lot No. \_\_\_\_\_, Recorded Plat \_\_\_\_\_  
5. Private Claims \_\_\_\_\_

I, Brian K. Fullford, in a field survey on Aug. 12, 1997 do hereby state that under requirements of P.A. 74, Michigan P.A. of 1970, the corner points mentioned in lines 1 and 2 above were in conformance with regulations and rules therefore as required in the current manual of survey instructions of the United States Department of the Interior, Bureau of Land Management or by a decree of a Court of Law and /or that the corner points mentioned in lines 3, 4 and 5 above were in conformance with the rules of the Michigan Board of Land Surveyors or by a Decree of a Court of Law; established, re-established, monumented, recovered, found as expressed below:

NOTE: Not more than 2 corners, all in the same town and range, may be recorded on this certificate.

	A	B	C	D	E	F	G	H	I	J	K	L	M
1													
2	6		5		4		3		2		1		
3													
4	7		8		9		10	●	11		12		
5													
6	18		17		16		15		14		13		
7													
8	19		20		21		22		23		24		
9													
10	30		29		28		27		26		25		
11													
12	31		32		33		34		35		36		
13													


- A. Description of original monument and accessories and/or subsequent restoration:
- |                            |                      |                         |                               |
|----------------------------|----------------------|-------------------------|-------------------------------|
| G.L.O.                     | 1908 David Bowen     | 1987 Delmer Porter      | 1988 James Granger #16041     |
| 1855 Harvey Mellen         | Cedar Post 4 X 5     | #15410                  | Fnd 3/4" pipe                 |
| Set 1/4 Section post       | flat and             | 1" pipe                 | 12" Maple N 49° W 36.20'      |
| 14" W. Birch S 5° E 20 lks | old hay fork at side | 12" Maple N 8° E 68.15' | 14" Maple N 35° W 54.07' RL;  |
| 12" Cedar S 45° E 28 lks   |                      | 14" Oak N 35° W 54.07'  | Tag #15410                    |
|                            |                      | 12" Oak N 49° W 36.20'  | 12" Hickory N 8° E 65.15' RL; |
|                            |                      |                         | Tag #15410                    |
|                            |                      |                         | 4" Poplar S 16° E 16.02'      |

- B. Description of corner evidence found and/or method applied in restoring or reestablishing corner:  
Found 3/4" pipe and 4 witnesses.

A.) Continued:

- 1961 Dean DeLaMater #5778  
T-iron with cap  
Maple cluster N 5° E 66.58'  
10" Spruce S 32° E 59.08'  
16" Elm N 20° W 70.10'

LIBER **011** PAGE **07**

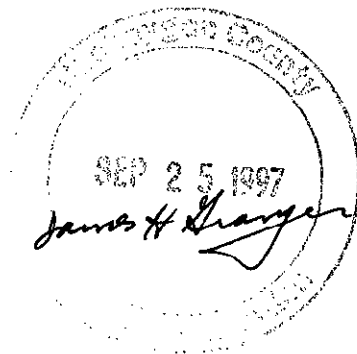

- C. Description of monument for corner and accessories established to perpetuate locating the position of the corner:

I-4 Placed 5/8" rebar and remonumentation cap inside pipe and is accepted as a careful and faithful perpetuation of the original.

- |                                  |               |
|----------------------------------|---------------|
| 17" Basswood Clump N 5° E 68.15' | W/ Tag 15410  |
| 20" Spruce S 30° E 58.10'        | Set Tag 41099 |
| 13" Maple N 48° W 36.23'         | Set Tag 41099 |
| 18" Maple N 38° W 54.00'         | W/ Tag 15410  |



Signed by B. K. Fullford  
Surveyor's Michigan License No. 41099

Date 11/21/97