

SURVEY & REMONUMENTATION

FEB 26 1998

SECTION CHEBOYGAN COUNTY REMONUMENTATION LAND CORNER RECORDATION CERTIFICATE
Filing Requirement of Act 74, Mich. P.A. 1970

For corners in
Cheboygan
(County)

Located In:	Corner Code #
T <u>36</u> N R <u>3</u> W	<u>J-5</u>
T ___ R ___	_____
T ___ R ___	_____
T ___ R ___	_____
S ___ T ___ R ___	_____
S ___ T ___ R ___	_____
S ___ T ___ R ___	_____
S ___ T ___ R ___	_____

RECEIVED FOR RECORD 12-18-97
at 11:05 O'Clock A.M.
Joanne Spray
CLERK/REGISTER
CHEBOYGAN COUNTY, MICHIGAN
Register of Deeds Stamp & File Number

- 1. Public Land Survey
- 2. Property Controlling in Section
- 3. Miscellaneous Property in Sec.
- 4. Lot No. _____, Recorded Plat _____
- 5. Private Claims _____

	A	B	C	D	E	F	G	H	I	J	K	L	M
1													
2	6		5		4		3		2		1		
3													
4	7		8		9		10		11		12		
5										●			
6	18		17		16		15		14		13		
7													
8	19		20		21		22		23		24		
9													
10	30		29		28		27		26		25		
11													
12	31		32		33		34		35		36		
13													

I, Brian K Fullford, in a field survey on Nov. 6, 1997 do hereby state that under requirements of P.A. 74, Michigan P.A. of 1970, the corner points mentioned in lines 1 and 2 above were in conformance with regulations and rules therefore as required in the current manual of survey instructions of the United States Department of the Interior, Bureau of Land Management or by a decree of a Court of Law and /or that the corner points mentioned in lines 3, 4 and 5 above were in conformance with the rules of the Michigan Board of Land Surveyors or by a Decree of a Court of Law; established, re-established, monumented, recovered, found as expressed below:

NOTE: Not more than 2 corners, all in the same town and range, may be recorded on this certificate.

- A. Description of original monument and accessories and/or subsequent restoration:
- | | | | |
|-------------------------|-----------------------|--------------------------|-------------------------|
| G.L.O. | 1908 David Bowen | 1961 Sup Plat of Green- | 1991 Norm Quaine #33984 |
| 1855 Harvey Mellen | 6 X 8 flat stone | man's Pt. | 3/4" pipe |
| Set 1/4 Section post | | Dean DeLaMaters #5778 | Gate cor N 61° W 92.95' |
| 5" Cedar S 71° W 25 lks | 1961 Dean DeLaMater | | P. Pole N 13° E 39.85' |
| 7" Sugar N 16° E 28 lks | 3/4 "iron pipe | 1964 Plat of White Goose | P. Pole S 7° W 41.61' |
| Old 1/4 cor S 70 1/2° W | P. Pole N 10° E 40.0' | Bay | |
| 58 lks | P. Pole N 54° E 65.0' | Kenneth Larsen #33984 | |
| | P. Pole S 04° W 41.7' | | |

B. Description of corner evidence found and/or method applied in restoring or reestablishing corner:
Found 3/4" pipe and 3 witnesses.

A.) Continued:

- | | |
|---------------------------|---------------------------|
| 1993 James Granger #16041 | 1996 David Grondin #39080 |
| Survey | 3/4" pipe |
| Liber 586, Pg 331,CCR | Gate cor. N 61° W 92.95' |
| | P. Pole N 13° E 39.85' |
| | P Pole S 7° W 41.61' |




C. Description of monument for corner and accessories established to perpetuate locating the position of the corner:

J-5 Placed 5/8" rebar w/remonumentation cap inside pipe and in monument box and is accepted as a careful and faithful perpetuation of the original corner.

- | | |
|----------------------------|---------------|
| Gate corner N 61° W 92.97' | W/ Tag |
| P. Pole N 13° E 39.82' | W/Tag |
| P. Pole S 7° E 42.06' | Set Tag 41099 |
| 7" Basswood S 40° E 65.24' | Set Tag 41099 |

LIBER **011** PAGE **09**

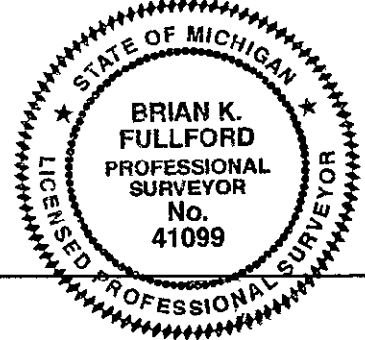

Signed by Brian K Fullford
Surveyor's Michigan License No. 41099

Date 11/21/97