

SURVEY & REMONUMENTATION

FEB 26 1998

SECTION

**CHEBOYGAN COUNTY REMONUMENTATION
LAND CORNER RECORDATION CERTIFICATE
Filing Requirement of Act 74, Mich. P.A. 1970**

For corners in
Cheboygan
(County)

| Located In: | Corner Code # |
|---|-----------------|
| T <u>36</u> N <u>R</u> <u>3</u> W | <u> </u> K-4 |
| T <u> </u> R <u> </u> | <u> </u> |
| T <u> </u> R <u> </u> | <u> </u> |
| T <u> </u> R <u> </u> | <u> </u> |
| S <u> </u> T <u> </u> R <u> </u> | <u> </u> |
| S <u> </u> T <u> </u> R <u> </u> | <u> </u> |
| S <u> </u> T <u> </u> R <u> </u> | <u> </u> |
| S <u> </u> T <u> </u> R <u> </u> | <u> </u> |

RECEIVED FOR RECORD 12-18-97
at 11:07 O'Clock AM
Joanne Spray
CLERK/REGISTER
CHEBOYGAN COUNTY, MICHIGAN
Register of Deeds Stamp & File Number

- 1. Public Land Survey
- 2. Property Controlling in Section
- 3. Miscellaneous Property in Sec.
- 4. Lot No. _____, Recorded Plat _____
- 5. Private Claims _____

| | A | B | C | D | E | F | G | H | I | J | K | L | M |
|----|----|---|----|---|----|---|----|---|----|---|----|---|---|
| 1 | | | | | | | | | | | | | |
| 2 | 6 | | 5 | | 4 | | 3 | | 2 | | 1 | | |
| 3 | | | | | | | | | | | | | |
| 4 | 7 | | 8 | | 9 | | 10 | | 11 | | 12 | | |
| 5 | | | | | | | | | | | | | |
| 6 | 18 | | 17 | | 16 | | 15 | | 14 | | 13 | | |
| 7 | | | | | | | | | | | | | |
| 8 | 19 | | 20 | | 21 | | 22 | | 23 | | 24 | | |
| 9 | | | | | | | | | | | | | |
| 10 | 30 | | 29 | | 28 | | 27 | | 26 | | 25 | | |
| 11 | | | | | | | | | | | | | |
| 12 | 31 | | 32 | | 33 | | 34 | | 35 | | 36 | | |
| 13 | | | | | | | | | | | | | |

I, Brian K. Fullford, in a field survey on Sept. 12, 1997 do hereby state that under requirements of P.A. 74, Michigan P.A. of 1970, the corner points mentioned in lines 1 and 2 above were in conformance with regulations and rules therefore as required in the current manual of survey instructions of the United States Department of the Interior, Bureau of Land Management or by a decree of a Court of Law and /or that the corner points mentioned in lines 3, 4 and 5 above were in conformance with the rules of the Michigan Board of Land Surveyors or by a Decree of a Court of Law; established, re-established, monumented, recovered, found as expressed below:


NOTE: Not more than 2 corners, all in the same town and range, may be recorded on this certificate.

- A. Description of original monument and accessories and/or subsequent restoration:
- | | | | |
|-------------------------|-----------------------|-----------------------------|-------------------------|
| G.L.O. | 1908 David Bowen | 1964 Orlando Doyle | 1992 James Granger |
| 1855 Harvey Mellen | Cedar post 3 1/2" Sq. | 1" pipe | #16041 |
| Set 1/4 Section post | 6" Spruce S 18° 30' W | 4" Cedar S 52° W 4.60' | 1/2" rod & cap #16041 |
| 6" Spruce S 18 1/2° W | 19 lks | 4" Cedar N 43° 30' W 13.20' | 10" Cedar S 9° E 2.72' |
| 19 lks | Cedar stake N 44° E | 4" Cedar S 49° 30' W 13.00' | 8" Cedar N 50° W 15.72' |
| 6" Cedar N 44° E 17 lks | | | 6" Cedar S 83° E 17.73' |
| | | | 4" Cedar N 9° E 5.63' |

- B. Description of corner evidence found and/or method applied in restoring or reestablishing corner:
Found 1/2" bar and cap #16041 and 4 witnesses.

- A.) Continued:
1993 Norm Quaine #33984
1/2" rod & cap #16041
4" Cedar S 86° E 17.64'
7" Cedar S 16° E 2.70'
5" Cedar N 53° W 15.76'
3" Cedar N 11° E 5.65'

LIBER **011** PAGE **11**

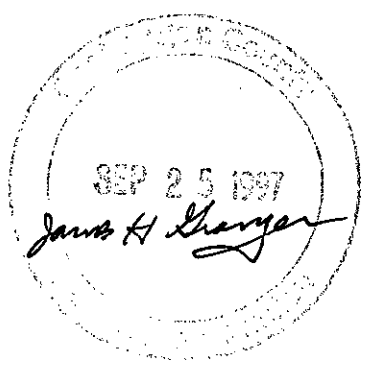

- C. Description of monument for corner and accessories established to perpetuate locating the position of the corner:
K-4 Placed 5/8" bar with remonumentation cap over top of 1/2" bar and cap and is accepted as a careful and faithful perpetuation of the original corner.

| | |
|-------------------------|------------------|
| 6" Cedar N 11° E 5.65' | Found tag #15410 |
| 10" Cedar S 16° E 2.70' | Found tag #15410 |
| 6" Cedar S 86° E 17.64' | Found tag #15410 |
| 7" Cedar N 53° W 15.76' | Found tag #15410 |



Signed by *Brian K. Fullford*
Surveyor's Michigan License No. 41099

Date 11/21/97