

**SURVEY & REMONUMENTATION**

**FEB 26 1998**

**SECTION**

**CHEBOYGAN COUNTY REMONUMENTATION  
LAND CORNER RECORDATION CERTIFICATE  
Filing Requirement of Act 74, Mich. P.A. 1970**

For corners in

Cheboygan  
(County)

Located In:

Corner Code #

1. Public Land Survey

T36N R 3W K-5  
T \_\_\_ R \_\_\_  
T \_\_\_ R \_\_\_  
T \_\_\_ R \_\_\_  
S \_\_\_ T \_\_\_ R \_\_\_  
S \_\_\_ T \_\_\_ R \_\_\_  
S \_\_\_ T \_\_\_ R \_\_\_  
S \_\_\_ T \_\_\_ R \_\_\_

2. Property Controlling In Section

3. Miscellaneous Property in Sec.

4. Lot No. \_\_\_\_\_, Recorded Plat \_\_\_\_\_

5. Private Claims \_\_\_\_\_

RECEIVED FOR RECORD 12-18-97  
of 11:08 O'Clock A M


*James Granger*

CLERK/REGISTER  
CHEBOYGAN COUNTY, MICHIGAN

Register of Deeds Stamp & File Number

I, Brian K. Fullford, in a field survey on Nov. 11, 1997 do hereby state that under requirements of P.A. 74, Michigan P.A. of 1970, the corner points mentioned in lines 1 and 2 above were in conformance with regulations and rules therefore as required in the current manual of survey instructions of the United States Department of the Interior, Bureau of Land Management or by a decree of a Court of Law and/or that the corner points mentioned in lines 3, 4 and 5 above were in conformance with the rules of the Michigan Board of Land Surveyors or by a Decree of a Court of Law; established, re-established, monumented, recovered, found as expressed below:

NOTE: Not more than 2 corners, all in the same town and range, may be recorded on this certificate.

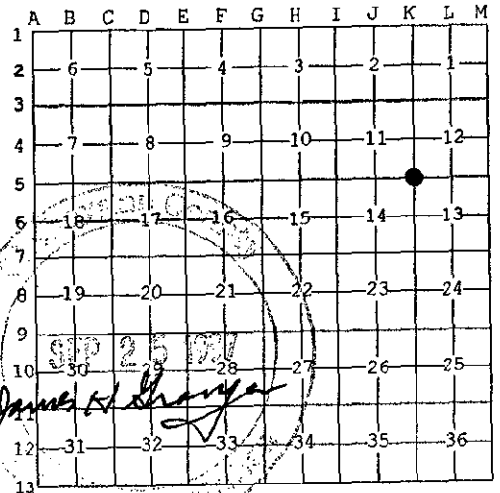

A. Description of original monument and accessories and/or subsequent restoration:

G.L.O.	1961 Dean DeLaMater	1988 James Granger	1991 Norm Quaine
1855 Harvey Mellen	#5778	#16041	#33984
Reestablish Sec. Cor.	1" X 1" angle iron	3/4" pipe	3/4" pipe
16" Hemlock N 51° W 36lks	P. Pole N 32° E 46.3'	10" Poplar S 42° E 62.00'	2" Apple N 13° W 38.80'
1908 David Bowen	Fence Post N 78° W	8" Poplar N 34° W 79.49'	P. Pole N 37° W 47.35'
Cedar post 4" Sq. with piece of gas pipe	119.8'	P. Pole N 36° E 47.36'	4" Elm S 74° W 62.20'
		4" Poplar N 3° E 50.06'	

B. Description of corner evidence found and/or method applied in restoring or reestablishing corner:

Found 3/4" pipe and 3 witnesses.

A.) Continued:

1993 James Granger #16041	1994 Richard Dunn #12020	1996 David Grondin #39080
3/4" pipe is recorded in Liber 2, Pg. 151, CCR.	3/4" pipe	3/4" pipe
	10" Poplar S 42° E 62.00'	P. Pole N 37° W 47.35'
	9" Poplar N 34° W 79.49'	2" Apple N 13° W 38.8'
	7" Poplar N 3° E 50.06'	4" Elm S 74° W 62.20'
	P. Pole N 36° E 47.35'	

C. Description of monument for corner and accessories established to perpetuate locating the position of the corner:

K-5 Placed 5/8" rebar with remonumentation cap inside pipe in monument box and position is accepted as a careful and faithful perpetuation of the original corner.

P. Pole N 37° E 47.35' W/Tag  
4" Apple N 13° W 38.80' W/Tag #1540  
6" Elm S 74° W 62.20' W/PK Nail  
12" Poplar S 34° E 56.03' Set Tag 41099

LIBER **011** PAGE **12**

Signed by *Brian K. Fullford*  
Surveyor's Michigan License No. 41099

Date 11/21/97

