

SURVEY & REMONUMENTATION

FEB 26 1998

SECTION

**CHEBOYGAN COUNTY REMONUMENTATION
LAND CORNER RECORDATION CERTIFICATE
Filing Requirement of Act 74, Mich. P.A. 1970**

For corners in
Cheboygan
(County)

Located In: Corner Code #

- | | | |
|------------------------------------|--------------------------|-------------|
| 1. Public Land Survey | T <u>36N</u> R <u>3W</u> | <u>K-10</u> |
| | T ___ R ___ | _____ |
| | T ___ R ___ | _____ |
| | T ___ R ___ | _____ |
| 2. Property Controlling in Section | S ___ T ___ R ___ | _____ |
| | S ___ T ___ R ___ | _____ |
| 3. Miscellaneous Property in Sec. | S ___ T ___ R ___ | _____ |
| | S ___ T ___ R ___ | _____ |

RECEIVED FOR RECORD 12-18-97
at 11:13 O'Clock A M

Jasanne Spray

CLERK/REGISTER
CHEBOYGAN COUNTY, MICHIGAN

Register of Deeds Stamp & File Number

4. Lot No. _____, Recorded Plat _____
5. Private Claims _____


I, Brian K. Fullford, in a field survey on Sept. 16, 1997 do hereby state that under requirements of P.A. 74, Michigan P.A. of 1970, the corner points mentioned in lines 1 and 2 above were in conformance with regulations and rules therefore as required in the current manual of survey instructions of the United States Department of the Interior, Bureau of Land Management or by a decree of a Court of Law and/or that the corner points mentioned in lines 3, 4 and 5 above were in conformance with the rules of the Michigan Board of Land Surveyors or by a Decree of a Court of Law; established, re-established, monumented, recovered, found as expressed below:

NOTE: Not more than 2 corners, all in the same town and range, may be recorded on this certificate.

	A	B	C	D	E	F	G	H	I	J	K	L	M
1													
2	6		5		4		3		2		1		
3													
4	7		8		9		10		11		12		
5													
6	18		17		16		15		14		13		
7													
8	19		20		21		22		23		24		
9													
10	30		29		28		27		26		25		
11													
12	31		32		33		34		35		36		
13													

- A. Description of original monument and accessories and/or subsequent restoration:
- | | | |
|------------------------------------|---|--------------------------|
| G.L.O. | 1956 Orlando Doyle | 1994 Richard Dunn #12020 |
| 1855 Harvey Mellen | Set 1" pipe | 1" pipe |
| Reestablish old 1/4 Section corner | 3/4" pipe SW side of Quad Birch N 26° E 77.58' | 15" Birch N 26° E 77.58' |
| 12" Hemlock N 57° W 17 lks | 3/4" pipe NE side of 12" W Birch N 34° 30' W 59.49' | 12" Birch N 37° W 61.85' |
| 20" Hemlock S 23° W 12 lks | 16" Beech S 40° W 62.75' | 24" Beech S 40° W 62.75' |
| | | Doyle Wit |
| | | 6" Maple S 27° E 51.25' |

- B. Description of corner evidence found and/or method applied in restoring or reestablishing corner:
Found 1" pipe and 2 witnesses.

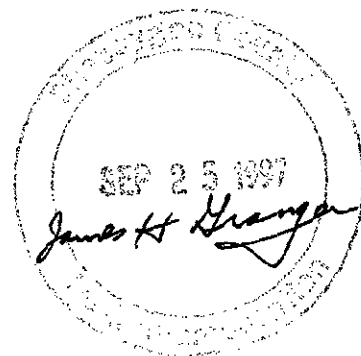

LIBER **011** PAGE **17**

- C. Description of monument for corner and accessories established to perpetuate locating the position of the corner:
K-10 Placed 5/8" rebar with remonumentation cap inside pipe, and is accepted as a careful and faithful perpetuation of the original corner.

- | | |
|---------------------------------|---------------|
| 12" Quad Birch N 26° E 77.18' | Set Tag 41099 |
| 6" W. Pine S 48° 30' E 46.79' | Set Tag 41099 |
| 7" Aspen S 27° 30' W 49.74' | Set Tag 41099 |
| 12" W. Birch N 34° 30' W 58.88' | Set Tag 41099 |

Signed by *B. K. Fullford*
Surveyor's Michigan License No. 41099

Date 11/21/97

