

SURVEY & REMONUMENTATION

FEB 26 1998

1997 CHEBOYGAN COUNTY, STATE OF MICHIGAN REMONUMENTATION

LAND CORNER RECORDATION CERTIFICATE
Filing Requirement of Act 74, Mich. P.A. 1970

SECTION

For corners in

Cheboygan
(County)

Located In:

Corner Code #

- | | | |
|------------------------------------|--|-------------|
| 1. Public Land Survey | T <u>36N</u> R <u>3W</u> | <u>K-12</u> |
| | T <u> </u> R <u> </u> | <u> </u> |
| | T <u> </u> R <u> </u> | <u> </u> |
| | T <u> </u> R <u> </u> | <u> </u> |
| 2. Property Controlling in Section | S <u> </u> T <u> </u> R <u> </u> | <u> </u> |
| | S <u> </u> T <u> </u> R <u> </u> | <u> </u> |
| 3. Miscellaneous Property in Sec. | S <u> </u> T <u> </u> R <u> </u> | <u> </u> |
| | S <u> </u> T <u> </u> R <u> </u> | <u> </u> |

RECEIVED FOR RECORD
at 9:22 O'Clock A M

Josanne Spray

CLERK/REGISTER
CHEBOYGAN COUNTY, MICHIGAN

Register of Deeds Stamp & File Number

4. Lot No. _____, Recorded Plat _____
5. Private Claims _____

Ronald Bischer, in a field survey on Oct 1, 19 97 do hereby state that under requirements of P.A. 74, Michigan P.A. of 1970, the corner points mentioned in lines 1 and 2 above were in conformance with regulations and rules therefore as required in the current manual of survey instructions of the United States Department of the Interior, Bureau of Land Management or by a decree of a Court of Law and/or that the corner points mentioned in lines 3, 4 and 5 above were in conformance with the rules of the Michigan Board of Land Surveyors or by a Decree of a Court of Law; established, re-established, monumented, recovered, found as expressed below:

NOTE: Not more than 2 corners, all in the same town and range, may be recorded on this certificate.

	A	B	C	D	E	F	G	H	I	J	K	L	M
1													
2	6		5		4		3		2		1		
3													
4	7		8		9		10		11		12		
5													
6	18		17		16		15		14		13		
7													
8	19		20		21		22		23		24		
9													
10	30		29		28		27		26		25		
11													
12	31		32		33		34		35		36		
13													

A. Description of original monument and accessories and/or subsequent restoration:

- | | |
|-------------------------|-------------------------------|
| K-12 | 1947 Joseph F. Doyle #3177 |
| GLO Notes | Set 1" Axle and two witnesses |
| Harvey Mellen | 1959 Dean DelaMater #5778 |
| 1855 Resurvey | Found 1" axle |
| Set Post | 1991 Norman Quaine #33984 |
| 12" Beech S72° E 25 lks | Found 1" Axle |
| 18" Beech N73 W 39 lks | Set Four witnesses |

B. Description of corner evidence found and/or method applied in restoring or reestablishing corner:


- K-12
- Found 1" Axle
and One Doyle witness
and three Quaine witnesses
Replaced 1" Axle with 5/8" Rod and Remon. Cap



LIBER **011** PAGE **70**

C. Description of monument for corner and accessories established to perpetuate locating the position of the corner:

- K-12
- 5/8" Rod and Cap
- | | | |
|---------------|----------------------------|----------------|
| S58° E 84.26' | Power Pole | Doyle witness |
| West 1.60' | Telephone Box | Quaine witness |
| S60° E 0.40' | Corner of Split rail fence | Quaine witness |
| N11 E 10.90' | 8" Cherry tree | Quaine witness |

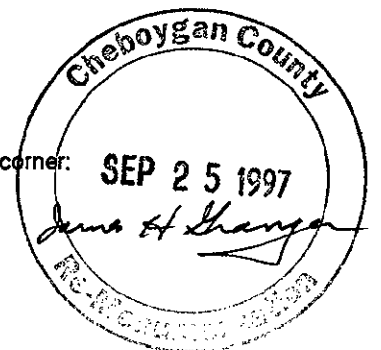

Signed by Ronald R. Bischer
Surveyor's Michigan License No. 22428

Date Oct 10, 1997