

SURVEY & REMONUMENTATION

FEB 26 1998

SECTION

CHEBOYGAN COUNTY REMONUMENTATION LAND CORNER RECORDATION CERTIFICATE
Filing Requirement of Act 74, Mich. P.A. 1970

For corners in
Cheboygan
(County)

Located In:	<u>T36N R 3W</u>	Corner Code #	<u>L-3</u>
	T ___ R ___		_____
	T ___ R ___		_____
	T ___ R ___		_____
1. Public Land Survey	S ___ T ___ R ___		_____
2. Property Controlling in Section	S ___ T ___ R ___		_____
3. Miscellaneous Property in Sec.	S ___ T ___ R ___		_____

RECEIVED FOR RECORD 12-18-97
at 11:15 O'Clock AM

Joanne Spray

CLERK/REGISTER
CHEBOYGAN COUNTY, MICHIGAN

Register of Deeds Stamp & File Number

4. Lot No. _____, Recorded Plat _____
5. Private Claims _____

I, Brian K. Fullford, in a field survey on Sept. 12, 1997 do hereby state that under requirements of P.A. 74, Michigan P.A. of 1970, the corner points mentioned in lines 1 and 2 above were in conformance with regulations and rules therefore as required in the current manual of survey instructions of the United States Department of the Interior, Bureau of Land Management or by a decree of a Court of Law and for that the corner points mentioned in lines 3, 4 and 5 above were in conformance with the rules of the Michigan Board of Land Surveyors or by a Decree of a Court of Law; established, re-established, monumented, recovered, found as expressed below:

NOTE: Not more than 2 corners, all in the same town and range, may be recorded on this certificate.

A	B	C	D	E	F	G	H	I	J	K	L	M
1												
2	6		5		4		3		2		1	
3												
4	7		8		9		10		11		12	
5												
6	18		17		16		15		14		13	
7												
8	19		20		21		22		23		24	
9												
10	30		29		28		27		26		25	
11												
12	31		32		33		34		35		36	
13												

- A. Description of original monument and accessories and/or subsequent restoration:
- G.L.O. 1967 Orlando Doyle #7319
 - 1855 Harvey Mellen Found 4 X 4 wood stk
 - Set Post 5" Hemlock N 34° W 5.50'
 - 10" W. Birch S 25 1/2° E 30 lks 14" Pine stump N 15° E 53.21'
 - 10" Cedar N 49 1/2° W 14 lks 4" Cedar S 17° E 15.42'

- B. Description of corner evidence found and/or method applied in restoring or reestablishing corner:
- Found 1" pipe and 2 witnesses and rotted remains of 14" pine stump.




LIBER **011** PAGE **19**

- C. Description of monument for corner and accessories established to perpetuate locating the position of the corner:

L-3 Placed 5/8" rebar with remonumentation cap inside 1" pipe, and is accepted as a careful and faithful perpetuation of the original corner.

- | | |
|---------------------------|---------------|
| 10" Hemlock N 31° W 5.60' | Set Tag 41099 |
| 8" Cedar S 15° E 15.61' | Set Tag 41099 |
| 12" Maple S 75° W 30.83' | Set Tag 41099 |
| 14" Poplar N 30° E 19.07' | Set Tag 41099 |

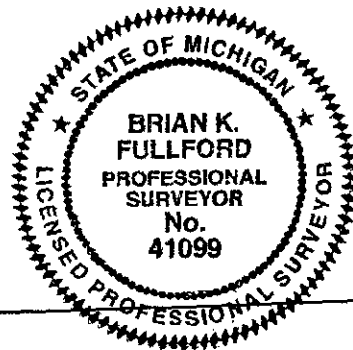

Signed by *Brian K. Fullford*
Surveyor's Michigan License No. 41099

Date 11/21/97