

SURVEY & REMONUMENTATION

FEB 26 1998

SECTION

CHEBOYGAN COUNTY REMONUMENTATION LAND CORNER RECORDATION CERTIFICATE

Filing Requirement of Act 74, Mich. P.A. 1970

For corners in
Cheboygan
(County)

Located In: Corner Code #

- | | | |
|------------------------------------|--------------------------|------------|
| 1. Public Land Survey | T <u>36N</u> R <u>3W</u> | <u>L-7</u> |
| | T ___ R ___ | _____ |
| | T ___ R ___ | _____ |
| | T ___ R ___ | _____ |
| 2. Property Controlling in Section | S ___ T ___ R ___ | _____ |
| | S ___ T ___ R ___ | _____ |
| 3. Miscellaneous Property in Sec. | S ___ T ___ R ___ | _____ |
| | S ___ T ___ R ___ | _____ |

RECEIVED FOR RECORD 12-18-97
at 11:17 O'Clock A M

Joanne Spray


CLERK/REGISTER
CHEBOYGAN COUNTY, MICHIGAN

Register of Deeds Stamp & File Number

4. Lot No. _____, Recorded Plat _____
5. Private Claims _____

I, Brian K. Fullford, in a field survey on Nov. 6, 19 97 do hereby state that under requirements of P.A. 74, Michigan P.A. of 1970, the corner points mentioned in lines 1 and 2 above were in conformance with regulations and rules therefore as required in the current manual of survey instructions of the United States Department of the Interior, Bureau of Land Management or by a decree of a Court of Law and/or that the corner points mentioned in lines 3, 4 and 5 above were in conformance with the rules of the Michigan Board of Land Surveyors or by a Decree of a Court of Law; established, re-established, monumented, recovered, found as expressed below:

NOTE: Not more than 2 corners, all in the same town and range, may be recorded on this certificate.

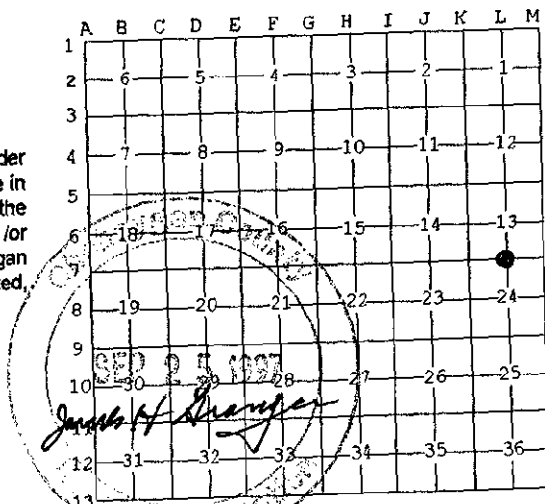

- A. Description of original monument and accessories and/or subsequent restoration:
- | | | |
|---------------------------|--------------------------------|--|
| G.L.O. | 1972 Orlando Doyle #7319 | 1979 Richard Bidstrup |
| 1855 Harvey Mellen | 3/4" iron pipe | Found 1/2" iron pipe |
| Set 1/4 Section Post | 20" Oak N 49° 30' W 99.52' | 18" Cottonwood N 76° E 87.9' |
| 10" Y. Pine South 4 lks | 10" Oak S 36° W 77.29' | 10" Oak S 33° W 77.2' Doyle Wit |
| 14" W. Pine S 66° W 7 lks | SW Conc. Porch S 64° E 97.32' | Fence corner N 42° W 46.2' |
| | Found & Witnesses by MDSH Crew | Survey recorded in Liber 401, Page 671 |

- B. Description of corner evidence found and/or method applied in restoring or reestablishing corner:
Found PK Nail in asphalt over top of 3/4" pipe and 4 witnesses per Bidstrup Survey.

**Note: Fence post removed between time of field investigation and final monument placement.

LIBER **011** PAGE **21**

- C. Description of monument for corner and accessories established to perpetuate locating the position of the corner:

- L-7 Place 5/8" rebar and remonumentation cap in monument box and is accepted as a careful and faithful perpetuation of the original corner.
- | | |
|--------------------------------------|---------------|
| 30" Cottonwood N 72° E 87.51' | Set Tag 41099 |
| 18" Tw. Oak S 31° W 77.20' | W/Tag 41099 |
| 30" Oak N 52° W 99.64' | W/Tag 41099 |
| NW Cor Blk Foundation S 74° E 89.81' | Set Tag 41099 |



Signed by *B. K. Fullford*
Surveyor's Michigan License No. 41099

Date 11/21/97