

FEB 26 1998

SECTION

1997 CHEBOYGAN COUNTY, STATE OF MICHIGAN REMONUMENTATION

LAND CORNER RECORDATION CERTIFICATE
Filing Requirement of Act 74, Mich. P.A. 1970

For corners in

CHEBOYGAN (County)

Located In:

Corner Code #

1. Public Land Survey

T36NR 3W T-13

T R

T R

T R

2. Property Controlling in Section

S T R

S T R

3. Miscellaneous Property in Sec.

S T R

S T R

4. Lot No. , Recorded Plat

5. Private Claims

RECEIVED FOR RECORD
of 9:51 O'Clock A M

Signature of Joanne Spray

CLERK/REGISTER
CHEBOYGAN COUNTY, MICHIGAN

Register of Deeds Stamp & File Number

I, Ronald Bischer, in a field survey on Oct 1, 19 97 do hereby state that under requirements of P.A. 74, Michigan P.A. of 1970, the corner points mentioned in lines 1 and 2 above were in conformance with regulations and rules therefore as required in the current manual of survey instructions of the United States Department of the Interior, Bureau of Land Management or by a decree of a Court of Law and /or that the corner points mentioned in lines 3, 4 and 5 above were in conformance with the rules of the Michigan Board of Land Surveyors or by a Decree of a Court of Law; established, re-established, monumented, recovered, found as expressed below:

NOTE: Not more than 2 corners, all in the same town and range, may be recorded on this certificate.


Grid table with columns A-M and rows 1-13. Numbers 6-36 are placed in specific cells.

A. Description of original monument and accessories and/or subsequent restoration:

L-13
GLO Notes
John Mullett
1840 Original Survey
Set Post
6" White Oak N62 E 13 lks
14" White Oak N21 W 38 lks

1954 Orlando Doyle #7319
Found 1" Pipe set 3 witnesses

1988 James Young #24626
Found 3/4" Pipe
Set two new witnesses

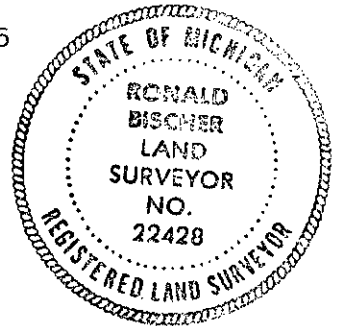

B. Description of corner evidence found and/or method applied in restoring or reestablishing corner:

L-13
Found 3/4" Pipe
also all three Doyle witnesses
and all Young witnesses
Replaced 3/4" pipe with 5/8" Rod and Remon. Cap

LIBER 011 PAGE 69

C. Description of monument for corner and accessories established to perpetuate locating the position of the corner:

L-13
5/8" Rod and Remon cap
N75 E 72.00' Conc. R/W marker Doyle witness
N43 W 98.04' 14" Red oak Doyle witness
S08 E 83.22' 25" Red Oak Doyle witness
S23 E 61.28' 10" White Oak Young witness
S87 E 87.72' Fence corner post Young witness



Signed by Ronald R. Bischer
Surveyor's Michigan License No. 22428

Date Oct. 10, 1997