

SURVEY &

CHEBOYGAN COUNTY REMONUMENTATION CORNER

JAN 23 1996

LAND CORNER RECORDATION CERTIFICATE

Filing Requirement of Act 74, Mich. P.A. 1970

For corners in

CHEBOYGAN COMMISSION  
(County)

Located In:

Corner Code #

Burt Township

- 1. Public Land Survey T 36NR 3W M-1  
T \_\_\_ R \_\_\_  
T \_\_\_ R \_\_\_  
T \_\_\_ R \_\_\_
- 2. Property Controlling S \_\_\_ T \_\_\_ R \_\_\_  
in Section S \_\_\_ T \_\_\_ R \_\_\_
- 3. Miscellaneous S \_\_\_ T \_\_\_ R \_\_\_  
Property in Sec. S \_\_\_ T \_\_\_ R \_\_\_

RECEIVED FOR RECORD  
95 SEP 18 AM 10:26

*Joanna Spray*  
CLERK/REGISTER  
CHEBOYGAN COUNTY, MICHIGAN

Register of Deeds Stamp & File Number

- 4. Lot No. \_\_\_\_\_, Recorded Plat \_\_\_\_\_
- 5. Private Claims \_\_\_\_\_

I, Ronald Bischer, in a field survey on July 7, 19 95, do hereby certify that under requirements of P.A. 74, Michigan P.A. of 1970, the corner points mentioned in lines 1 and 2 above were in conformance with regulations and rules therefore as required in the current manual of survey instructions of the United States Department of the Interior, Bureau of Land Management or by a decree of a Court of Law and/or that the corner points mentioned in lines 3, 4 and 5 above were in conformance with the rules of the Michigan Board of Land Surveyors or by a Decree of a Court of Law; established, re-established, monumented, re-monumented, recovered, found as expressed below:

NOTE: Not more than 4 corners, all in the same town and range, may be recorded on this certificate.

	A	B	C	D	E	F	G	H	I	J	K	L	M
2	6	5	4	3	2	1							
3													
4	7	8	9	10	11	12							
5													
6	18	17	16	15	14	13							
7													
8	19	20	21	22	23	24							
9													
10	30	29	28	27	26	25							
11													
12	31	32	33	34	35	36							
13													


A. Description of original monument and accessories and/or subsequent restoration:

1840 Original Survey  
John Mullett  
Set wood post  
15" Beech N30°W 12 lks  
9" Maple N77°E 36 lks

No record of subsequent restoration.

B. Description of corner evidence found and/or method applied in restoring or reestablishing corner:


Found 1" Bolt buried 18" deep and also 4" x 4" Cedar stake point.  
Replaced with 5/8" Rod with Cheboygan County Remonumentation cap.  
Set four witnesses.

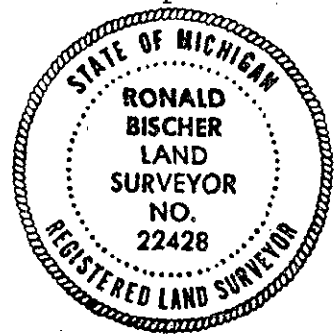

C. Description of monument for corner and accessories established to perpetuate locating the position of the corner:

5/8" Rod with Cheboygan County Remonumentation cap  
S70°W 53.06' Power pole  
N84°W 24.42' Telephone cable box  
S61°E 39.02' Telephone cable box  
N58°E 48.04' Corner fence post

Nails with witness tag #22428 used.

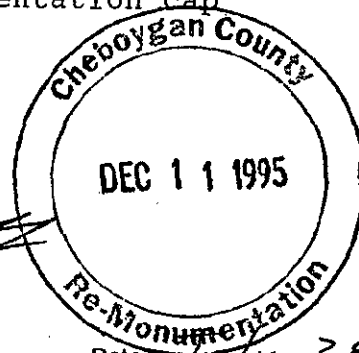

LIBER 010 PAGE 119

Witnessed by Ronald R. Bischer

Date July 28, 1995

Surveyor's Michigan License No. 22428