

**SURVEY &
MONUMENTATION**
CHEBOYGAN COUNTY REMONUMENTATION CORNER

JAN 23 1996

LAND CORNER RECORDATION CERTIFICATE
Filing Requirement of Act 74, Mich. P.A. 1970

For corners in **COMMISSION**

<u>CHEBOYGAN</u> <small>(County)</small>	Located In:	Corner Code =#
<u>Burt Township</u>		
1. Public Land Survey	T <u>36N</u> R <u>3W</u>	<u>M-2</u>
	T _____ R _____	_____
	T _____ R _____	_____
	T _____ R _____	_____
2. Property Controlling in Section	S _____ T _____	_____
	S _____ T _____	_____
3. Miscellaneous	S _____ T _____	_____
Property in Sec.	S _____ T _____	_____
4. Lot No. _____, Recorded Plat _____		
5. Private Claims _____		

RECEIVED
FOR RECORD
95 SEP 18 AM 10:22

Josmo Spray
CLERK/REGISTER
CHEBOYGAN COUNTY, MICHIGAN

Register of Deeds Stamp & File Number

I, Ronald Bischer, in a field survey on July 7, 19 95, do hereby certify that under requirements of P.A. 74, Michigan P.A. of 1970, the corner points mentioned in lines 1 and 2 above were in conformance with regulations and rules therefore as required in the current manual of survey instructions of the United States Department of the Interior, Bureau of Land Management or by a decree of a Court of Law and/or that the corner points mentioned in lines 3, 4 and 5 above were in conformance with the rules of the Michigan Board of Land Surveyors or by a Decree of a Court of Law; established, re-established, monumented, re-monumented, recovered, found as expressed below:

A	B	C	D	E	F	G	H	I	J	K	L	M
2	6	5	4	3	2	1						
3												
4	7	8	9	10	11	12						
5												
6	18	17	16	15	14	13						
7												
8	19	20	21	22	23	24						
9												
10	30	29	28	27	26	25						
11												
12	31	32	33	34	35	36						
13												

NOTE: Not more than 4 corners, all in the same town and range, may be recorded on this certificate.

A. Description of original monument and accessories and/or subsequent restoration:


1840 Original Survey SW 70.50' 8" Poplar
John Mullett SE 36.70' Fence cor.
Set wood post
6" Spruce S38°E 5 lks
6" Cedar S38°W 9 lks

1968 Survey
Orlando Doyle
Found 1/2" Iron Bar

B. Description of corner evidence found and/or method applied in restoring or reestablishing corner:

Found 1/2" Rod and old stake, replace with 5/8" rod and Cheboygan County Remonumentation cap.
S60°W 70.50' 16" Aspen
S45°E 36.70' Fence corner

Maxim P. Pass

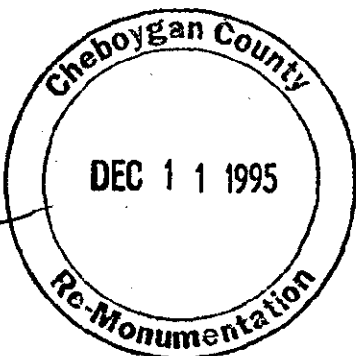

C. Description of monument for corner and accessories established to perpetuate locating the position of the corner:

5/8" Rod with Cheboygan County Remonumentation cap
S60°W 70.50' 16" Aspen
S45°E 36.70' Fence corner
N47°E 29.99' Power pole
S16°W 84.94' 8" Elm

Nails with witness tag #22428 used.

LIBER 010 PAGE 118

igned by Ronald R. Bischer

Date July 28, 1995

urveyor's Michigan License No. 22428