

**CHEBOYGAN COUNTY REMONUMENTATION CORNER**

**LAND CORNER RECORDATION CERTIFICATE**

Filing Requirement of Act 74, Mich. P.A. 1970

For corners in JAN 23 1996

CHEBOYGAN COMMISSION  
(County)

Located In:

Corner Code #

Burt Township

1. Public Land Survey	T <u>36</u> N R <u>3</u> W	<u>M-3</u>
	T ___ R ___	_____
	T ___ R ___	_____
	T ___ R ___	_____
2. Property Controlling in Section	S ___ T ___ R ___	_____
	S ___ T ___ R ___	_____
3. Miscellaneous Property in Sec.	S ___ T ___ R ___	_____
	S ___ T ___ R ___	_____

RECEIVED FOR RECORD

95 SEP 18 AM 10:20

*Joanna Spray*

CLERK/REGISTER  
CHEBOYGAN COUNTY, MICHIGAN

Register of Deeds Stamp & File Number

4. Lot No. \_\_\_\_\_, Recorded Plat \_\_\_\_\_  
5. Private Claims \_\_\_\_\_

I, Ronald Bischer, in a field survey on July 7, 19 95, do hereby certify that under requirements of P.A. 74, Michigan P.A. of 1970, the corner points mentioned in lines 1 and 2 above were in conformance with regulations and rules therefore as required in the current manual of survey instructions of the United States Department of the Interior, Bureau of Land Management or by a decree of a Court of Law and/or that the corner points mentioned in lines 3, 4 and 5 above were in conformance with the rules of the Michigan Board of Land Surveyors or by a Decree of a Court of Law, established, re-established, monumented, re-monumented, recovered, found as expressed below:

**NOTE: Not more than 4 corners, all in the same town and range, may be recorded on this certificate.**

A	B	C	D	E	F	G	H	I	J	K	L	M
2	6	5	4	3	2	1						
3												
4	7	8	9	10	11	12						
5												
6	18	17	16	15	14	13						
7												
8	19	20	21	22	23	24						
9												
10	30	29	28	27	26	25						
11												
12	31	32	33	34	35	36						
13												



**A. Description of original monument and accessories and/or subsequent restoration:**

1840 Original Survey	N41°W 72.58' 39" Oak	S20°E 62.89' 8" Apple
John Mullett	S82°W 47.81' 25" Oak	N84°W 26.19' Fence cor.
Set wood post		S48°W 57.06' 8" Spruce
7" Lynn N48°W 16 lks	1968 Survey	S83°E 27.90' Fe. post
6" Cedar N77°E 27 lks	Orlando Doyle #7319	
	Found 1/2" Iron Bar	
1964 Survey	SE 63.10' 8" Apple	
Kenneth R. Larsen #10695	W 25.90' Fence Cor.	
Found 1/2" Iron in concrete		
S53°W 92.40' 18" Oak	1989 Survey	
	James H. Granger #16041	

**B. Description of corner evidence found and/or method applied in restoring or reestablishing corner:**

Found 1/2" Boat Spike, replaced with 5/8" Rod and Cheboygan County Remonumentation cap.  
S23°E 63.10' 12" Apple tree  
West 26.64' Fence corner

*Manion O. Pelt*

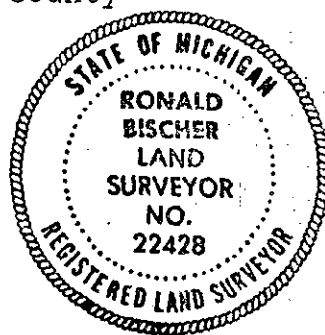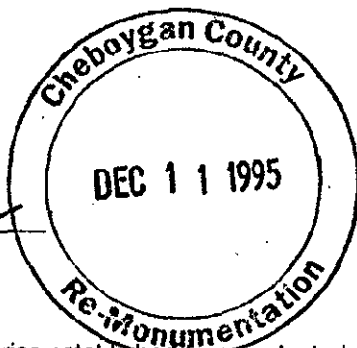

**Description of monument for corner and accessories established to perpetuate locating the position of the corner:**

5/8" Rod with Cheboygan County Remonumentation cap  
S23°E 63.10' 12" Apple tree  
West 26.64' Fence corner  
East 27.78' Fence corner  
S72°W 62.60' NE corner of house

LIBER 010 PAGE 117

Nails with witness tag #22428 used.

Recorded by Ronald R. Bischer

Date July 28, 1995

Surveyor's Michigan License No. 22428