

COMMISSION

For corners in

CHEBOYGAN (County)

Located In:

Corner Code -#

- Burt Township
- Public Land Survey
T 36NR 3W M-4
T R
T R
T R
 - Property Controlling in Section
S T R
S T R
 - Miscellaneous Property in Sec.
S T R
S T R
 - Lot No. _____, Recorded Plat _____
 - Private Claims _____

RECEIVED FOR RECORD

95 SEP 18 AM 10:19

Joanna Spray
CLERK/REGISTER
CHEBOYGAN COUNTY, MICHIGAN

Register of Deeds Stamp & File Number

I, Ronald Bischer, in a field survey on July 6, 19 95, do hereby certify that under requirements of P.A. 74, Michigan P.A. of 1970, the corner points mentioned in lines 1 and 2 above were in conformance with regulations and rules therefore as required in the current manual of survey instructions of the United States Department of the Interior, Bureau of Land Management or by a decree of a Court of Law and/or that the corner points mentioned in lines 3, 4 and 5 above were in conformance with the rules of the Michigan Board of Land Surveyors or by a Decree of a Court of Law; established, re-established, monumented, re-monumented, recovered, found as expressed below:

NOTE: Not more than 4 corners, all in the same town and range, may be recorded on this certificate.

A	B	C	D	E	F	G	H	I	J	K	L	M
2	6	5	4	3	2	1						
3												
4	7	8	9	10	11	12						
5												
6	18	17	16	15	14	13						
7												
8	19	20	21	22	23	24						
9												
10	30	29	28	27	26	25						
11												
12	31	32	33	34	35	36						
13												

A. Description of original monument and accessories and/or subsequent restoration:


- 1840 Original Survey
John Mullett
Set wood post
6" Hemlock N73°E 5 lks
6" Hemlock S47°W 6 lks
- 1967 Survey
Orlando Doyle #7319
Set 1" Pipe
N66°E 65.04' 6" W. Birch
- 1989 Survey
James H. Granger #16041
Found 1" Rod
N41°W 53.77' 6" Maple
N68°E 56.75' 6" Birch
S59°E 34.79' 6" Poplar
S46°W 59.09' 8" R. Oak

1989 Survey
James H. Granger #16041
same as other Granger information

B. Description of corner evidence found and/or method applied in restoring or reestablishing corner:

- Found 1" Rod, replace rod with 5/8" Rod and Cheboygan County Remonumentation cap
S41°W 59.09' 10" Red Oak
N45°W 53.77' 8" Maple
N66°E 56.75' 6" White Birch (dead)

Martin G. Ross

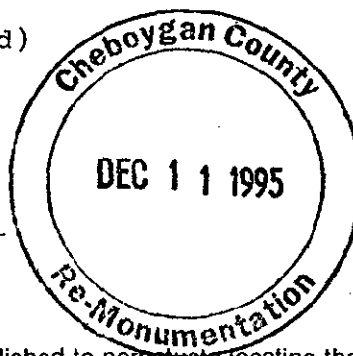

C. Description of monument for corner and accessories established to perpetuate locating the position of the corner:

- 5/8" Rod with Cheboygan County Remonumentation cap
S41°W 59.09' 10" Red Oak
N45°W 53.77' 8" Maple
N75°E 46.38' 6" White Pine
S31°E 87.40' 7" Maple

LIBER 010 PAGE 116

Nails with witness tag #22428 used.

Signed by Ronald R. Bischer

Date July 28, 1995

Surveyor's Michigan License No. 22428