

SURVEY &
MONUMENTATION
CHEBOYGAN COUNTY REMONUMENTATION CORNER

JAN 23 1996 LAND CORNER RECORDATION CERTIFICATE
Filing Requirement of Act 74, Mich. P.A. 1970

For corners in

CHEBOYGAN
(County)

COMMISSION

Located In:

Corner Code ##

Burt Township

1. Public Land Survey	T	36N	R	3W	M-5
	T		R		
	T		R		
	T		R		
	T		R		
2. Property Controlling in Section	S		T	R	
	S		T	R	
3. Miscellaneous Property in Sec.	S		T	R	
	S		T	R	

RECEIVED FOR RECORD

95 SEP 18 AM 10:18

James Spray
CLERK/REGISTER
CHEBOYGAN COUNTY, MICHIGAN

Register of Deeds Stamp & File Number

- 4. Lot No. _____, Recorded Plat _____
- 5. Private Claims _____

I, Ronald Bischer, in a field survey on July 6, 19 95, do hereby certify that under requirements of P.A. 74, Michigan P.A. of 1970, the corner points mentioned in lines 1 and 2 above were in conformance with regulations and rules therefore as required in the current manual of survey instructions of the United States Department of the Interior, Bureau of Land Management or by a decree of a Court of Law and/or that the corner points mentioned in lines 3, 4 and 5 above were in conformance with the rules of the Michigan Board of Land Surveyors or by a Decree of a Court of Law; established, re-established, monumented, re-monumented, recovered, found as expressed below:

NOTE: Not more than 4 corners, all in the same town and range, may be recorded on this certificate.

1. Description of original monument and accessories and/or subsequent restoration:

1840 Original Survey	1971 Survey
John Mullett	C. Eugene Ostling #12026
Set wood post	Found 1" Pipe
12" Beech S19°W 12 lks	N70°W 40.15' P. Pole
15" Beech N16°W 6 lks	S45°E 65.05' P. Pole
1960 Survey	N20°E 69.00' 18" Oak
Dean C. DeLaMater #5778	1979 Survey
Found 3/4" gas pipe	Ronald R. Bischer #22428
S35°W 87.73' 16" Maple	Found 5/8" Rod
N70°W 73.90' 11" Oak	

DeLaMater and Ostling witnesses agree with 5/8" Rod location.
1989 Survey
James H. Granger #16041
Found Bolt and three old witnesses.
N86°E 81.17' 24" Poplar
(new witness)


A	B	C	D	E	F	G	H	I	J	K	L	M
2	6	5	4	3	2	1						
3												
4	7	8	9	10	11	12						
5												
6	18	17	16	15	14	13						
7												
8	19	20	21	22	23	24						
9												
10	30	29	28	27	26	25						
11												
12	31	32	33	34	35	36						
13												

3. Description of corner evidence found and/or method applied in restoring or reestablishing corner:

Found 5/8 Bar inside 1" Pipe, set Cheboygan County Remonumentation cap on 5/8" Bar.

S41°W	56.03'	Power pole
S48°E	65.32'	Power pole
N72°W	74.12'	20" Oak
S34°W	87.90'	28" Maple
N55°W	5.88'	1" Bar

Martin A. Ross

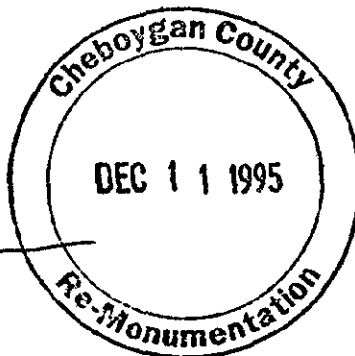

2. Description of monument for corner and accessories established to perpetuate locating the position of the corner:

5/8" Bar inside 1" pipe with Cheboygan County Remonumentation cap

S41°W	56.03'	Power pole
S48°E	65.32'	Power pole
N72°W	74.12'	20" Oak
S34°W	87.90'	28" Maple
N55°W	5.88'	1" Bar

LIBER 010 PAGE 115

Nails with witness tag #22428 used.

Signed by Ronald R. Bischer Date July 20, 1995

Surveyor's Michigan License No. 22428