

CHEBOYGAN COUNTY REMONUMENTATION CORNER

JAN 23 1996

LAND CORNER RECORDATION CERTIFICATE

COMMISSION Filing Requirement of Act 74, Mich. P.A. 1970

For corners in

CHEBOYGAN
(County)

Located In:

Corner Code #

1. Public Land Survey	T	36N	R	3W	M-8
	T		R		
	T		R		
	T		R		
2. Property Controlling in Section	S		T	R	
	S		T	R	
3. Miscellaneous Property in Sec.	S		T	R	
	S		T	R	

RECEIVED FOR RECORD

95 SEP 18 AM 10:12

James Spray
CLERK/REGISTER
CHEBOYGAN COUNTY, MICHIGAN

Register of Deeds Stamp & File Number

4. Lot No. _____, Recorded Plat _____
5. Private Claims _____

	A	B	C	D	E	F	G	H	I	J	K	L	M
2	6	5	4	3	2	1							
3													
4	7	8	9	10	11	12							
5													
6	18	17	16	15	14	13							
7													
8	19	20	21	22	23	24							
9													
10	30	29	28	27	26	25							
11													
12	31	32	33	34	35	36							
13													

I, Ronald Bischer, in a field survey on July 6, 1995, do hereby certify that under requirements of P.A. 74, Michigan P.A. of 1970, the corner points mentioned in lines 1 and 2 above were in conformance with regulations and rules therefore as required in the current manual of survey instructions of the United States Department of the Interior, Bureau of Land Management or by a decree of a Court of Law and/or that the corner points mentioned in lines 3, 4 and 5 above were in conformance with the rules of the Michigan Board of Land Surveyors or by a Decree of a Court of Law; established, re-established, monumented, re-monumented, recovered, found as expressed below:

NOTE: Not more than 4 corners, all in the same town and range, may be recorded on this certificate.

1. Description of original monument and accessories and/or subsequent restoration:

1840 Original Survey	1972 Survey	
John Mullett	Orlando Doyle	
Set Wood post	1" Pipe	
9" Beech N46°W 20 lks	N47°E 68.75'	Power pole #CN3-33C
9" Beech S13°E 14 lks	S52°E 25.59'	5" N. Pine
	S41°W 27.48'	4" Maple in clump

2. Description of corner evidence found and/or method applied in restoring or reestablishing corner:

Found 1" Pipe, replaced pipe with 5/8" Rod and Cheboygan County Remonumentation cap.
N45°E 68.69' Power pole
S52°E 27.48' 8" Maple
S40°W 25.59' 18" N. Pine




LIBER 010 PAGE 112

3. Description of monument for corner and accessories established to perpetuate locating the position of the corner:

5/8" Rod with Cheboygan County Remonumentation cap
N45°E 68.69' Power pole
S52°E 27.48' 8" Maple
S40°W 25.59' 18" Norway Pine
N71°W 48.70' 8" Aspen

Nails with tag #22428 used.

Morwin A. Ross

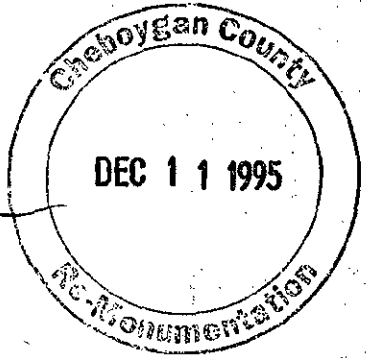

signed by Ronald B. Bischer

Date July 28, 1995

Surveyor's Michigan License No. 22428