

CHEBOYGAN COUNTY REMONUMENTATION CORNER.
LAND CORNER RECORDATION CERTIFICATE
COMMISSION Filing Requirement of Act 74, Mich. P.A. 1970

For corners in

CHEBOYGAN (County)	Located In:	Corner Code #/
Burt Township	T 36N R 3W	M-9
1. Public Land Survey	T _____ R _____	_____
	T _____ R _____	_____
	T _____ R _____	_____
	T _____ R _____	_____
2. Property Controlling in Section	S _____ T _____ R _____	_____
	S _____ T _____ R _____	_____
3. Miscellaneous Property in Sec.	S _____ T _____ R _____	_____
	S _____ T _____ R _____	_____

RECEIVED
FOR RECORD
95 SEP 18 AM 10:11
Joanne Spray
CLERK/REGISTER
CHEBOYGAN COUNTY, MICHIGAN
Register of Deeds Stamp & File Number

4. Lot No. _____, Recorded Plat _____
 5. Private Claims _____

I, Ronald Bischer, in a field survey on July 5, 19 95, do hereby certify that under requirements of P.A. 74, Michigan P.A. of 1970, the corner points mentioned in lines 1 and 2 above were in conformance with regulations and rules therefore as required in the current manual of survey instructions of the United States Department of the Interior, Bureau of Land Management or by a decree of a Court of Law and/or that the corner points mentioned in lines 3, 4 and 5 above were in conformance with the rules of the Michigan Board of Land Surveyors or by a Decree of a Court of Law; established, re-established, monumented, re-monumented, recovered, found as expressed below:

	A	B	C	D	E	F	G	H	I	J	K	L	M
2	6	5	4	3	2	1							
3													
4	7	8	9	10	11	12							
5													
6	18	17	16	15	14	13							
7													
8	19	20	21	22	23	24							
9													
10	30	29	28	27	26	25							
11													
12	31	32	33	34	35	36							
13													

NOTE: Not more than 4 corners, all in the same town and range, may be recorded on this certificate.


A. Description of original monument and accessories and/or subsequent restoration:

1840 Original Survey	N66°30'E 37.55'	6" Oak
John Mullett	1972 Survey	
6" Pine N50°W 25 lks	Orlando Doyle #7319	
6" Pine S28°E 33 lks	3/4" Iron pipe	
1948, 1956 Survey	S41°W 17.51'	8" Elm
Orlando Doyle #7319	S74°E 13.56'	4" Maple
Found Cedar stake, set 3/4" Pipe.	N35°W 14.71'	4" Maple
S54°30'W 44.80'		
N44°W 38.05'		

B. Description of corner evidence found and/or method applied in restoring or reestablishing corner:

Found 3/4" Pipe, replaced pipe with 5/8" Rod and Cheboygan County Remonumentation cap.

S37°W 17.51'	8" White Oak (tree is dead)
S73°E 13.56'	6" Maple
N37°W 14.71'	6" Red Oak
S54°W 44.80'	18" Red Oak
N65°E 37.55'	10" White Oak
N45°W 38.05'	8" Red Oak
West 33.11'	Concrete monument with cap #39080 (Grondin)

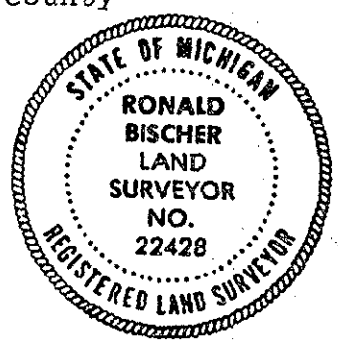

LIBER 010 PAGE 111


Description of monument for corner and accessories established to perpetuate locating the position of the corner:

5/8" Rod with Cheboygan County Remonumentation cap

S73°E 13.56'	6" Maple
N37°W 14.71'	6" Red Oak
S54°W 44.80'	18" Red Oak
N65°E 37.55'	10" White Oak
N45°W 38.05'	8" Red Oak

Nails with witness tag #22428 used.

Merrill Ross

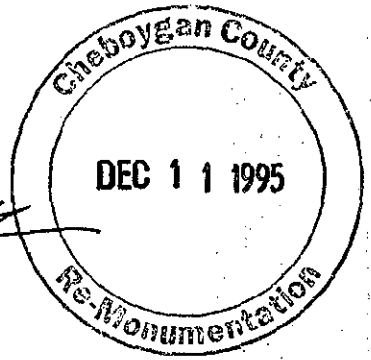

Recorded by Ronald E. Bischer Date July 28, 1995
 Surveyor's Michigan License No. 22428