

CHEBOYGAN COUNTY REMONUMENTATION CORNER
LAND CORNER RECORDATION CERTIFICATE

JAN 23 1996

COMMISSION Filing Requirement of Act 74, Mich. P.A. 1970

For corners in

<u>CHEBOYGAN</u> (County)	Located In:	Corner Code #
<u>Burt Township</u>	T <u>36N</u> R <u>3W</u>	<u>M-10</u>
1. Public Land Survey	T _____ R _____	_____
	T _____ R _____	_____
	T _____ R _____	_____
2. Property Controlling in Section	S _____ T _____ R _____	_____
	S _____ T _____ R _____	_____
3. Miscellaneous Property in Sec.	S _____ T _____ R _____	_____
	S _____ T _____ R _____	_____

RECEIVED
FOR RECORD
95 SEP 18 AM 10:10
James Gray
CLERK/REGISTER
Register of Deeds State of Michigan

4. Lot No. _____, Recorded Plat _____
5. Private Claims _____

A	B	C	D	E	F	G	H	I	J	K	L	M
2	6	5	4	3	2	1						
3												
4	7	8	9	10	11	12						
5												
6	18	17	16	15	14	13						
7												
8	19	20	21	22	23	24						
9												
10	30	29	28	27	26	25						
11												
12	31	32	33	34	35	36						
13												


I, Ronald Bischer, in a field survey on July 5, 19 95, do hereby certify that under requirements of P.A. 74, Michigan P.A. of 1970, the corner points mentioned in lines 1 and 2 above were in conformance with regulations and rules therefore as required in the current manual of survey instructions of the United States Department of the Interior, Bureau of Land Management or by a decree of a Court of Law and/or that the corner points mentioned in lines 3, 4 and 5 above were in conformance with the rules of the Michigan Board of Land Surveyors or by a Decree of a Court of Law; established, re-established, monumented, re-monumented, recovered, found as expressed below:

NOTE: Not more than 4 corners, all in the same town and range, may be recorded on this certificate.

A. Description of original monument and accessories and/or subsequent restoration:
 1840 Original Survey 8" Maple S01 30'W 41.00'
 John Mullett 1973 Survey
 Set wood post C. Eugene Ostling
 20" Pine S85°W 94 lks Found 3/4" Pipe - no
 6" W. Oak N43°W 70 lks witnesses recorded
 1948, 1956 Survey 1973 Survey
 Orlando Doyle Orlando Doyle
 Set 3/4" Pipe Found 3/4" Pipe
 24" Oak S54°30'W 44.80' 14" W. Oak N28°W 57.76"
 5" Oak N44°W 38.05' 9" Maple S06°W 40.82' 36" Red Oak S34°W 65.11'

B. Description of corner evidence found and/or method applied in restoring or reestablishing corner:
 Found Concrete Monument, set Cheboygan County Remonumentation cap
 N33°W 57.76' 18" White Oak
 S32°W 65.11' 33" Red Oak
 S01°W 40.82' 11" Maple


LIBER 010 PAGE 110

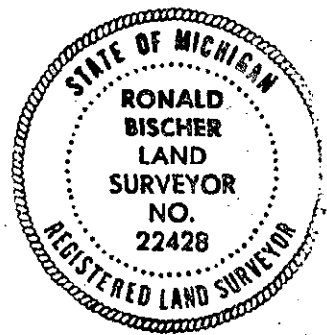

C. Description of monument for corner and accessories established to perpetuate locating the position of the corner:
 Concrete monument with Cheboygan County Remonumentation cap
 N33°W 57.76' 18" White Oak
 S32°W 65.11' 33" Red Oak
 S01°W 40.82' 11" Maple
 N83°E 32.60' 1" Pipe

Nails with witness tag #22428 used.

Martin A. Peck

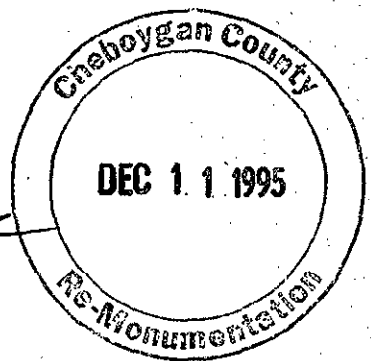

signed by Ronald R. Bischer Date July 28, 1995
 Surveyor's Michigan License No. 22428