

CHEBOYGAN COUNTY REMONUMENTATION CORNER

JAN 23 1996

LAND CORNER RECORDATION CERTIFICATE

COMMISSION

Filing Requirement of Act 74, Mich. P.A. 1970

For corners in

CHEBOYGAN

(County)

Burt Township

Located In:

Corner Code #

- 1. Public Land Survey T 36N R 3W M-13
- T R
- T R
- T R
- 2. Property Controlling S T R
- in Section S T R
- 3. Miscellaneous S T R
- Property in Sec. S T R
- 4. Lot No. _____, Recorded Plat _____
- 5. Private Claims _____

RECEIVED FOR RECORD
95 SEP 18 AM 9:57
James Spray
CLERK/REGISTER
CHEBOYGAN COUNTY, MICHIGAN
Register of Deeds Stamp & File Number

I, Ronald Bischer, in a field survey on July 5, 19 95, do hereby certify that under requirements of P.A. 74, Michigan P.A. of 1970, the corner points mentioned in lines 1 and 2 above were in conformance with regulations and rules therefore as required in the current manual of survey instructions of the United States Department of the Interior, Bureau of Land Management or by a decree of a Court of Law and/or that the corner points mentioned in lines 3, 4 and 5 above were in conformance with the rules of the Michigan Board of Land Surveyors or by a Decree of a Court of Law, established, re-established, monumented, re-monumented, recovered, found as expressed below:

NOTE: Not more than 4 corners, all in the same town and range, may be recorded on this certificate.

A. Description of original monument and accessories and/or subsequent restoration:

- 1840 Original Survey 1961 - Dean C. DeLaMater Found conc. mon. & 2 witnesses.
- John Mullett Set Wood Post 1990 - Dwight Schofield Found conc. mon. & 2 wit., set 2 new wit.
- 12" W. Oak S31 W 48 lks. 1990 - Dwight Schofield Found pipe, replaced with conc. mon. set 3 witnesses. same as above
- 18" Pine N07 E 87 lks. 1990 - Clifford C. Lindgren Found 1/2" Re-rod, placed
- 1946 - Orlando Doyle
- 1954 - Orlando Doyle Conc. mon. & 3 witnesses.



B. Description of corner evidence found and/or method applied in restoring or reestablishing corner:

- Concrete monument in Monument box, set Cheboygan County Remonumentation cap.
- S42°W 91.77' 26" Red Oak - old recorded witness
- N43°W 71.65' 36" Twin Red Oak - MSHD tag
- S17°E 22.02' Power pole - old recorded witness
- S07°E 81.85' Power pole - old recorded witness
- S49°W 79.14' 8" Aspen - MSHD tag
- N13°30'E 49.29' Power pole - tag on side of pole (MSHD)
- " " 48.85' Power pole - tag on face of pole

LIBER 010 PAGE 107

C. Description of monument for corner and accessories established to perpetuate locating the position of the corner:

- Concrete monument with Cheboygan County Remonumentation cap in monument box.
- S42°W 91.77' 26" Red Oak
- N43°W 71.65' 36" Twin Red Oak
- S17°E 22.02' Power pole
- S07°E 81.85' Power pole
- S49°W 79.14' 8" Aspen
- N13°30"E 49.29' Power pole
- Nails with witness tag #22428 used.

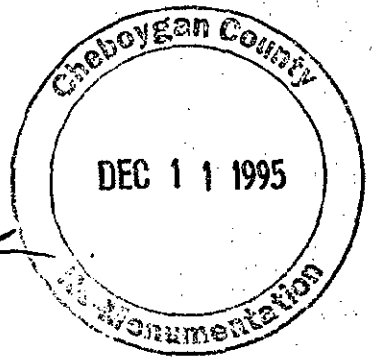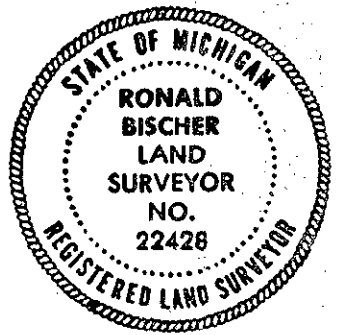

Signed by Ronald R. Bischer Date July 28, 1995
Surveyor's Michigan License No. 22428

	A	B	C	D	E	F	G	H	I	J	K	L	M
2	6	5	4	3	2	1							
3													
4	7	8	9	10	11	12							
5													
6	18	17	16	15	14	13							
7													
8	19	20	21	22	23	24							
9													
10	30	29	28	27	26	25							
11													
12	31	32	33	34	35	36							
13													

monument box over corner, 4 witnesses.