

LAND CORNER RECORDATION CERTIFICATE
Filing Requirement of Act 74, Mich. P.A. 1970

For corners in

CHEBOYGAN
 (County)

Located in: _____ Corner Code # _____

1. Public Land Survey
 T ___ R ___
 T ___ R ___
 T ___ R ___
 T ___ R ___

2. Property Controlling
 in Section S 36 T 36 R 3W Other # MC 7
 S ___ T ___ R ___
 S ___ T ___ R ___

3. Miscellaneous
 Property in Sec. S ___ T ___ R ___
 S ___ T ___ R ___

10-22-97
 RECEIVED FOR RECORD
 at 9:07 O'Clock AM
Joanne Spray
 CLERK/REGISTRAR
 CHEBOYGAN COUNTY, MICHIGAN
 Register of Deeds Stamp & File Number

4. Lot No. _____, Recorded Plat _____
 5. Private Claims _____

	A	B	C	D	E	F	G	H	I	J	K	L	M
1													
2	6		5		4		3		2		1		
3													
4	7		8		9		10		11		12		
5													
6	18		17		16		15		14		13		
7													
8	19		20		21		22		23		24		
9													
10	30		29		28		27		26		25		
11													
12	31		32		33		34		35		36		
13													

I, Ronald Bischer, in a field survey on Oct 1, 1997 do hereby state that under requirements of P.A. 74, Michigan P.A. of 1970, the corner points mentioned in lines 1 and 2 above were in conformance with regulations and rules therefore as required in the current manual of survey instructions of the United States Department of the Interior, Bureau of Land Management or by a decree of a Court of Law and/or that the corner points mentioned in lines 3, 4 and 5 above were in conformance with the rules of the Michigan Board of Land Surveyors or by a Decree of a Court of Law; established, re-established, monumented, recovered, found as expressed below:

NOTE: Not more than 2 corners, all in the same town and range, may be recorded on this certificate.


A. Description of original monument and accessories and/or subsequent restoration:

MC Between K-13 & L-13
 GLO notes 1966 Orlando Doyle #7319
 John Mullett Set Concrete Monument
 1840 Original Survey 1988 James Young #24626
 Set Post Found Concrete Monument
 8" Tamarack N53° E 24 lks and set three witnesses
 6" Willow S76° E 20 lks

B. Description of corner evidence found and/or method applied in restoring or reestablishing corner:

MC
 Found Broken Conc. Monument
 replaced with 5/8" Rod and Remon. Cap
 Found all three Young Witnesses

SURVEY & REMONUMENTATION
 FEB 26 1998

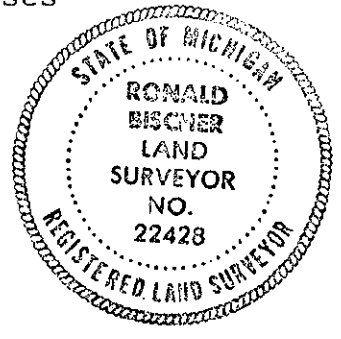


SECTION

C. Description of monument for corner and accessories established to perpetuate locating the position of the corner:

MC
 5/8" Rod and Remon. Cap

N05° E	28.62'	15" Cedar	Young Witness
N75° E	8.01'	7" Cedar	Young witness
N35° E	45.97'	7" Balsam	Young witness
S40° E	23.05'	Center of Well	

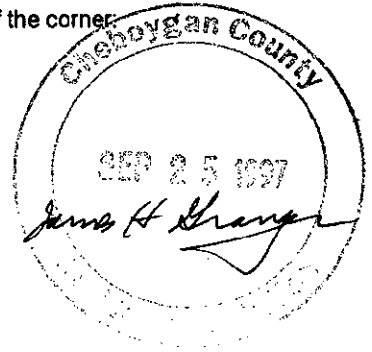

LIBER **011** PAGE **55**

Signed by Ronald R. Bischer Date Oct. 10, 1997
 Surveyor's Michigan License No. 22428