

RECEIVED FOR RECORD

1999 CHEBOYGAN COUNTY REMONUMENTATION LAND CORNER RECORDATION CERTIFICATE Filing Requirement of Act 74, Mich. P.A. 1970

00 JAN -3 PM 12: 41

For corners in Cheboygan (County)

Table with columns: Located In: (T, R, S), Corner Code # (4, 12)

Wicki Pyzyrski CLERK/REGISTER CHEBOYGAN COUNTY MICHIGAN

MAR 03 2000

SECTION

Register of Deeds Stamp & File Number

4. Lot No. Recorded Plat 5. Private Claims

I, Brian K. Fullford, in a field survey on August 19, 99 do hereby state that under requirements of P.A. 74, Michigan P.A. of 1970, the corner points mentioned in lines 1 and 2 above were in conformance with regulations and rules therefore as required in the current manual of survey instructions of the United States Department of the Interior, Bureau of Land Management or by a decree of a Court of Law and /or that the corner points mentioned in lines 3, 4 and 5 above were in conformance with the rules of the Michigan Board of Land Surveyors or by a Decree of a Court of Law; established, re-established, monumented, recovered, found as expressed below.

NOTE: Not more than 2 corners, all in the same town and range, may be recorded on this certificate.

Grid table with columns A-L and rows 1-13, containing numbers 1-36.

A. Description of original monument and accessories and/or subsequent restoration:

Resurvey 1855 Old corner in lake (unknown what was set) 10.94 chains East of 1/4 post 20" Hemlock S63°W 15 Lks. 12" Beech N4°E 49 Lks.

Feb. 1991 N. DeYoung Rls. #20705 No corner shown Survey drawing only w/bearing & distance from N 1/4 Corner only


B. Description of corner evidence found and/or method applied in restoring or reestablishing corner:

Fnd. 1" pipe Conc Mon S13°W 133.56' per Cottage Shores Condo Drawing L 539, Pg 430 T. Bar w/cap S13°W 33.56' per Cottage Shores Condo Drawing L 539, Pg 430



C. Description of monument for corner and accessories established to perpetuate locating the position of the corner:

D-5 - E-5 Set 5/8" X 36" iron bar and remonumentation cap inside 1" pipe. Position is accepted as a careful and faithful re-establishment of a witness corner to the original corner. Witness corner is 20.9 feet West of original corner Witness corner is 744.9 feet East of North 1/4 corner. 44" Maple S27°W 15.40' Set tag 41099 22" maple N82°W 20.90' Set tag 41099 4" Basswood S79°E 9.33' Set tag 41099 Edge of water East 33.0'

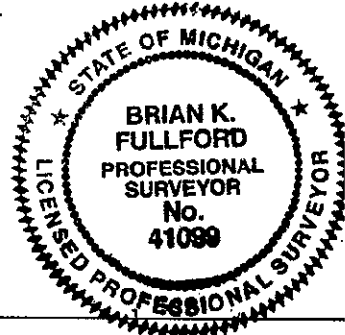

Signed by [Signature] Surveyor's Michigan License No. 41099

Date 12/17/99