

SURVEY &
REMONUMENTATION

1993

COMMISSION

CHEBOYGAN COUNTY REMONUMENTATION CORNER
LAND CORNER RECORDATION CERTIFICATE
Filing Requirement of Act 74, Mich. P.A. 1970

For corners in

CHEBOYGAN (County)	Located In:	Corner Code #
1. Public Land Survey	T <u>37N</u> R <u>1E</u>	<u>A-3</u>
	T _____ R _____	_____
	T _____ R _____	_____
	T _____ R _____	_____
2. Property Controlling in Section	S _____ T _____ R _____	_____
	S _____ T _____ R _____	_____
3. Miscellaneous Property in Sec.	S _____ T _____ R _____	_____
	S _____ T _____ R _____	_____

RECEIVED
FOR RECORD
93 DEC 22 AM 10:52

Joanna Gray
CLERK/REGISTER
CHEBOYGAN COUNTY, MICHIGAN

Register of Deeds Stamp & File Number

4. Lot No. _____, Recorded Plat _____
5. Private Claims _____


	A	B	C	D	E	F	G	H	I	J	K	L	M
2	6	5	4	3	2	1							
3													
4	7	8	9	10	11	12							
5													
6	18	17	16	15	14	13							
7													
8	19	20	21	22	23	24							
9													
10	30	29	28	27	26	25							
11													
12	31	32	33	34	35	36							
13													

I, Ronald R. Bischer, in a field survey on September 23, 19 93, do hereby certify that under requirements of P.A. 74, Michigan P.A. of 1970, the corner points mentioned in lines 1 and 2 above were in conformance with regulations and rules therefore as required in the current manual of survey instructions of the United States Department of the Interior, Bureau of Land Management or by a decree of a Court of Law and/or that the corner points mentioned in lines 3, 4 and 5 above were in conformance with the rules of the Michigan Board of Land Surveyors or by a Decree of a Court of Law; established, re-established, monumented, re-monumented, recovered, found as expressed below:

NOTE: Not more than 4 corners, all in the same town and range, may be recorded on this certificate.

A. Description of original monument and accessories and/or subsequent restoration:

A-3	Original Survey - June 1840	Conservation Dept. Monument
	John Hodgson set Wood Post	10" Aspen N04°E 92 links
	14" Beech N30°W 13 links	6" W. Birch S47°E 59 links
	7" Beech S07°E 20 links	8" Red Oak N78°W 1.24 chains
	1950 - Dean DeLaMater	1963 - Kenneth Ostling
	found 1½" Pipe previously set	Found Conservation Dept. Monument
	by Marcus Schaff	No record of witnesses found
	Replaced 1½" Pipe with	

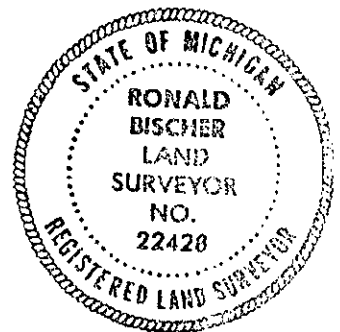

B. Description of corner evidence found and/or method applied in restoring or reestablishing corner:

A-3
Found Conservation Department Monument
10" Aspen N04°E 92 links
found stump
6" W. Birch S47°E 59 links
Dead
8" Red Oak N78°W 1.24 chains
Gone


LIBER 010 PAGE 27

C. Description of monument for corner and accessories established to perpetuate locating the position of the corner:

A-3
Conservation Department Monument
S47°E 35.67' 10" White Birch
N37°E 11.03' 8" Aspen
S44°W 15.46' 5" Maple
S88°W 29.31' 8" White Pine

Set nail with witness tag #22428 in witnesses.

Marcus A. Schaff

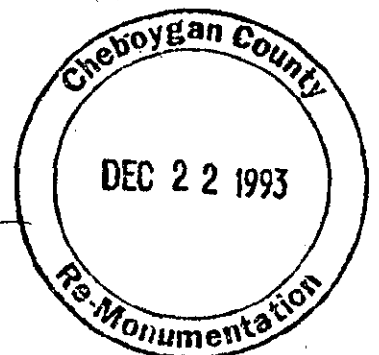

Signed by Ronald R. Bischer Date 12-03-93
Surveyor's Michigan License No. 22428