

**SURVEY &
REMONUMENTATION**

1993

COMMISSION

**CHEBOYGAN COUNTY REMONUMENTATION CORNER
LAND CORNER RECORDATION CERTIFICATE
Filing Requirement of Act 74, Mich. P.A. 1970**

For corners in

<u>CHEBOYGAN</u> (County)	Located In:	Corner Code <u>##</u>
1. Public Land Survey	T <u>37N</u> R <u>1E</u>	<u>A-4</u>
	T _____ R _____	_____
	T _____ R _____	_____
	T _____ R _____	_____
2. Property Controlling in Section	S _____ T _____ R _____	_____
	S _____ T _____ R _____	_____
3. Miscellaneous Property in Sec.	S _____ T _____ R _____	_____
	S _____ T _____ R _____	_____

4. Lot No. _____, Recorded Plat _____
5. Private Claims _____

RECEIVED
FOR RECORD
93 DEC 22 AM 11:11
James Spring
CLERK/REGISTER
CHEBOYGAN COUNTY, MICHIGAN
Register of Deeds Stamp & File Number


	A	B	C	D	E	F	G	H	I	J	K	L	M
2	6	5	4	3	2	1							
3													
4	7	8	9	10	11	12							
5													
6	18	17	16	15	14	13							
7													
8	19	20	21	22	23	24							
9													
10	30	29	28	27	26	25							
11													
12	31	32	33	34	35	36							
13													

I, Ronald R. Bischer, in a field survey on September 22, 19 93, do hereby certify that under requirements of P.A. 74, Michigan P.A. of 1970, the corner points mentioned in lines 1 and 2 above were in conformance with regulations and rules therefore as required in the current manual of survey instructions of the United States Department of the Interior, Bureau of Land Management or by a decree of a Court of Law and/or that the corner points mentioned in lines 3, 4 and 5 above were in conformance with the rules of the Michigan Board of Land Surveyors or by a Decree of a Court of Law; established, re-established, monumented, re-monumented, recovered, found as expressed below:

NOTE: Not more than 4 corners, all in the same town and range, may be recorded on this certificate.

A. Description of original monument and accessories and/or subsequent restoration:

A-4	
Original Survey - June 1840	10" R. Pine S81°E 13.6'
John Hodgson set Wood Post	8" R. Pine N40°W 21.7'
7" Beech S29°E 5 links	1965 - Kenneth Larsen
7" Beech N22°E 16 links	Conservation Dept. Monument
1965 - Kenneth Ostling	same witnesses as above
Set Conservation Dept. Monument	

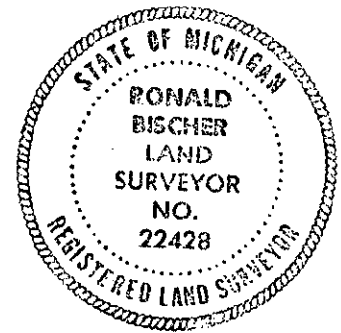


B. Description of corner evidence found and/or method applied in restoring or reestablishing corner:

A-4
Found Conservation Department Monument
S81°E 13.60' 12" Red Pine
N40°W 21.70' 12" Red Pine

LIBER **010** PAGE **31**

C. Description of monument for corner and accessories established to perpetuate locating the position of the corner:

A-4
Conservation Department Monument
S81°E 13.60' 12" Red Pine
N40°W 21.70' 12" Red Pine
S12°E 7.65' 12" Red Pine
N50°E 27.92' 11" Red Pine

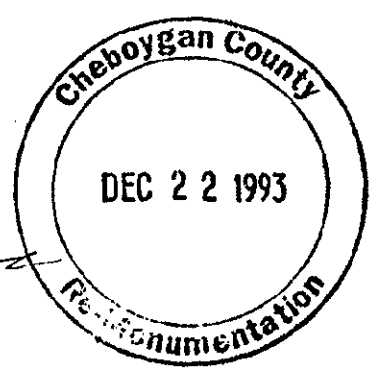

Set nail with witness tag #22428 in witnesses.

Signed by Ronald R. Bischer Date 12-03-93
Surveyor's Michigan License No. 22428