

SURVEY & REMONUMENTATION

1993

CHEBOYGAN COUNTY

**CHEBOYGAN COUNTY REMONUMENTATION CORNER
LAND CORNER RECORDATION CERTIFICATE
Filing Requirement of Act 74, Mich. P.A. 1970**

For corners in

CHEBOYGAN
(County)

Located In:

Corner Code #

1. Public Land Survey	T <u>37N</u> R <u>1E</u>	<u>A-7</u>
	T _____ R _____	_____
	T _____ R _____	_____
	T _____ R _____	_____
2. Property Controlling in Section	S _____ T _____ R _____	_____
	S _____ T _____ R _____	_____
3. Miscellaneous Property in Sec.	S _____ T _____ R _____	_____
	S _____ T _____ R _____	_____

RECEIVED FOR RECORD

93 DEC 22 AM 10:50

Joanna Gray
CLERK/REGISTER
CHEBOYGAN COUNTY, MICHIGAN

Register of Deeds Stamp & File Number

4. Lot No. _____, Recorded Plat _____
5. Private Claims _____


	A	B	C	D	E	F	G	H	I	J	K	L	M
2	6	5	4	3	2	1							
3													
4	7	8	9	10	11	12							
5													
6	18	17	16	15	14	13							
7													
8	19	20	21	22	23	24							
9													
10	30	29	28	27	26	25							
11													
12	31	32	33	34	35	36							
13													

I, Ronald R. Bischer, in a field survey on September 21, 19 93, do hereby certify that under requirements of P.A. 74, Michigan P.A. of 1970, the corner points mentioned in lines 1 and 2 above were in conformance with regulations and rules therefore as required in the current manual of survey instructions of the United States Department of the Interior, Bureau of Land Management or by a decree of a Court of Law and/or that the corner points mentioned in lines 3, 4 and 5 above were in conformance with the rules of the Michigan Board of Land Surveyors or by a Decree of a Court of Law; established, re-established, monumented, re-monumented, recovered, found as expressed below:

NOTE: Not more than 4 corners, all in the same town and range, may be recorded on this certificate.

A. Description of original monument and accessories and/or subsequent restoration:

A-7	1840 Original Survey (June 1840)	1965 - Kenneth Ostling
	John Hodgson set Wood Post	Found 1-1/2" Pipe
	6" Balsam S61°E 9 links	same witnesses as aforementioned
	14" Pine S86°W 29 links	1966 - Kenneth Larsen
	1963 - Kenneth Ostling	1-1/2" Pipe
	2" Pipe	Same witnesses as aforementioned
	24" Red Pine N62°W 26'	
	12" Spruce S34°E 16.7'	

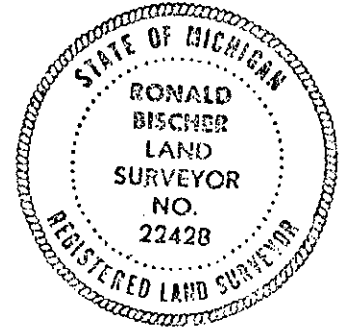

B. Description of corner evidence found and/or method applied in restoring or reestablishing corner:

A-7
Found 1-1/2" Pipe
24" Red Pine N62°W 26'
set nail w/tag at recorded distance
12" Spruce S34°E 16.7'
set nail w/tag at recorded distance

Replaced 1-1/2" Pipe with Cheboygan County Remonumentation Monument.


LIBER 010 PAGE 26

C. Description of monument for corner and accessories established to perpetuate locating the position of the corner:

A-7
Cheboygan County Remonumentation Monument
N62°W 26.00' 26" Red Pine
S34°E 16.70' 14" Spruce
S47°W 16.29' 6" Red Pine
N59°E 21.20' 16" Red Pine

Set nail with witness tag #22428 in witnesses.

Marcus A. Fox

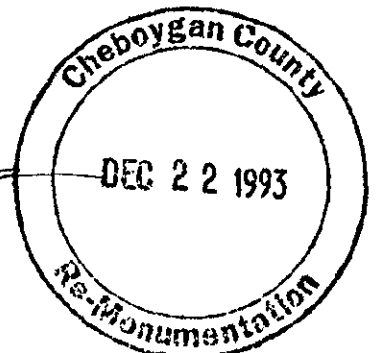

Signed by Ronald R. Bischer Date 12-03-93

Surveyor's Michigan License No. 22428