

SURVEY & REMONUMENTATION

Denta
105
COMMISSION

1993

**CHEBOYGAN COUNTY REMONUMENTATION CORNER
LAND CORNER RECORDATION CERTIFICATE**
Filing Requirement of Act 74, Mich. P.A. 1970

For corners in

<u>CHEBOYGAN</u> (County)	Located In:	Corner Code #
1. Public Land Survey	T <u>37N</u> R <u>1E</u>	<u>A-8</u>
	T _____ R _____	_____
	T _____ R _____	_____
	T _____ R _____	_____
2. Property Controlling in Section	S _____ T _____ R _____	_____
	S _____ T _____ R _____	_____
3. Miscellaneous Property in Sec.	S _____ T _____ R _____	_____
	S _____ T _____ R _____	_____
4. Lot No. _____, Recorded Plat _____		
5. Private Claims _____		

RECEIVED
FOR RECORD
93 DEC 22 AM 10:28

James Spring
Register of Deeds / REGISTERED CLERK
CHEBOYGAN COUNTY, MICHIGAN


I, Ronald R. Bischer, in a field survey on September 21, 19 93, do hereby certify that under requirements of P.A. 74, Michigan P.A. of 1970, the corner points mentioned in lines 1 and 2 above were in conformance with regulations and rules therefore as required in the current manual of survey instructions of the United States Department of the Interior, Bureau of Land Management or by a decree of a Court of Law and/or that the corner points mentioned in lines 3, 4 and 5 above were in conformance with the rules of the Michigan Board of Land Surveyors or by a Decree of a Court of Law; established, re-established, monumented, re-monumented, recovered, found as expressed below:

	A	B	C	D	E	F	G	H	I	J	K	L	M
2	6		5		4		3		2		1		
3													
4	7		8		9		10		11		12		
5													
6	18		17		16		15		14		13		
7													
8	19		20		21		22		23		24		
9													
10	30		29		28		27		26		25		
11													
12	31		32		33		34		35		36		
13													

NOTE: Not more than 4 corners, all in the same town and range, may be recorded on this certificate.

A. Description of original monument and accessories and/or subsequent restoration:

A-8
Original Survey - June 21, 1840 1963 - Kenneth Ostling
John Hodgson set Wood Post Found pipe
10" Beech N84°W 21 links Did not witness pipe
12" Beech S44°E 30 links
1854 Resurvey - Geo. H. Cannon found
and used Wood Post set by John
Hodgson - Distance to stream 433 ft.

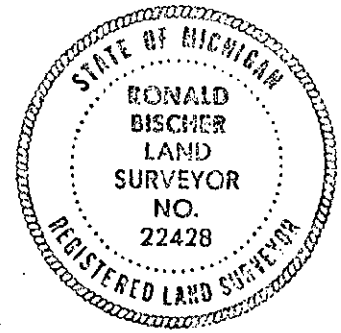

B. Description of corner evidence found and/or method applied in restoring or reestablishing corner:

A-8
Found 3/4" Pipe
No witnesses found.
Pipe is at approximate single proportion location, distance from stream is approximately the same distance (430 feet) as stated in Geo H. Cannon field notes (433 feet).


Replaced 3/4" Pipe with Cheboygan County Remonumentation Monument.

LIBER - 010 PAGE 20

C. Description of monument for corner and accessories established to perpetuate locating the position of the corner:

A-8
Cheboygan County Remonumentation Monument
N57°E 37.26' 7" Maple
N08°W 76.79' 10" Maple
S73°W 62.20' 16" Aspen
S72°E 61.48' 6" Maple

Marcus A. Ross

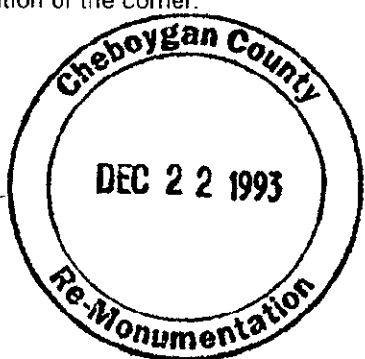

Set nail with witness tag #22428 in witnesses.

Signed by Ronald R. Bischer Date 12-03-93
Surveyor's Michigan License No. 22428